IREDELL COUNTY HEALTH DEPARTMENT

STATESVILLE 704-878-5305 MOORESVILLE 704-664-5281

4750 89 6164

IMPROVEMENT PERMIT / CERTIFICATE OF COMPLETION / OPERATION PERMIT / EXISTING SYSTEM INSPECTION

PROPERTY DESCRIPTION NO. 16905 DATE 9/13/93 TAX MAP NO. 4G 4 A 51

OWNER OR CONTRACTOR MELVIN GRAHAM INC PHONE: Business 552-5538 Home

ADDRESS 7707 PARK RD. CHAR. NC.

LOCATION WEATHERS CRK RD.

SUBDIVISION PHESANT RUN BLOCK / SECTION III LOT 51 LOT AREA .508 SITE CLASS. P L.T.A.R. .15-.2

Water Supply: ☑ Individual ☐ Community ☐ Public

Septic Tank: 1000 Gallons; STB 825 Date 10.5.0

Pump Tank: 1000 Gallons; PT 47 Date 1087

Nitrification Field: No Fields 1 Square Feet ~~360~~ Aeus Linear Feet ~~360~~ 500

No Lines ~~6~~ 5 Trench Width ~~3'~~ 24" Trench Depth ~~36~~ 30" Gravel Depth ~~12"~~ 12"

☑ New System ☐ Repair System Type: I, II, III (IV) V, VI

System Description: PRESCONV. HOUPPBPS - PUMP

Repair System Description: 16"PPBPS - PUMP

Maintenance Agreement Required: ☑ Yes ☐ No

☑ House/Mod. Home No. Bedrooms 3 Garbage Disposal: ☐ Yes ☑ No

☐ Mobile Home No. Bathrooms 2 Auto. Dishwasher: ☑ Yes ☐ No


☐ Business No. Employees Auto. Washing Machine: ☑ Yes ☐ No

☐ Other Other

☐ Slab ☑ Crawl Space ☐ Basement w/plumbing ☐ Basement wo/plumbing

Comments MAXIMUM TRENCH DEPTH 30" TO TRENCH BOTTOM
GATE VALVES - STAND PIPES SET AS SHOWN - NO MARGIN FOR SHIFTING
QUESTIONS TO ICHD BEFORE INSTALLATION
MAINTENANCE AGREEMENT REQUIRED.

INITIAL SITE SKETCH

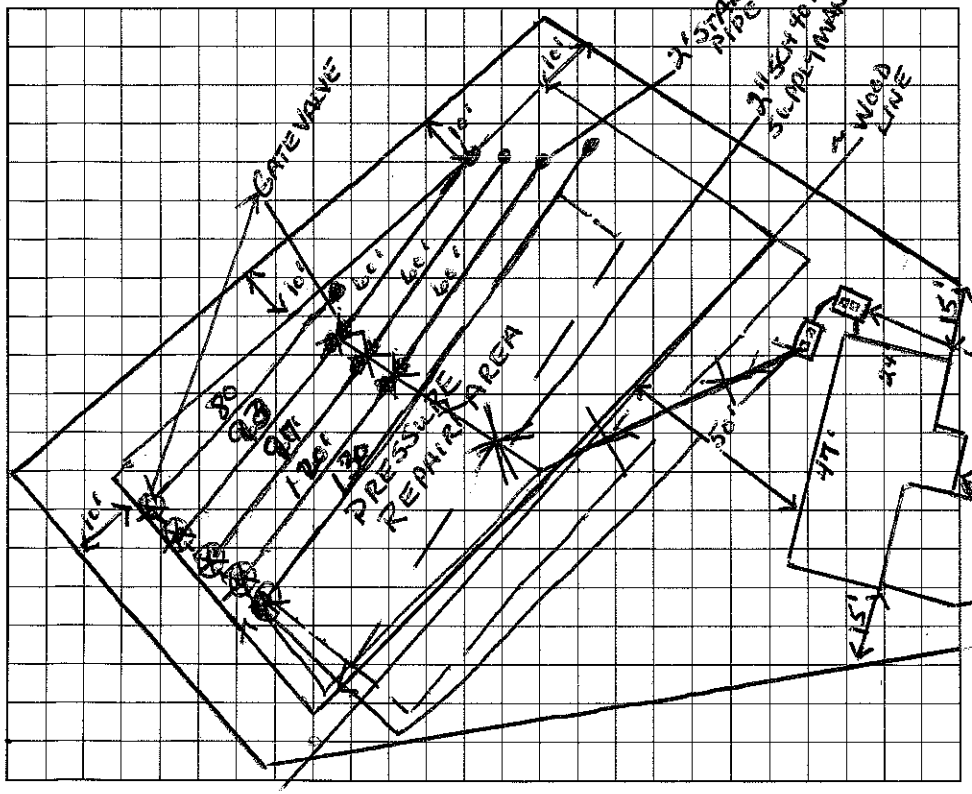

AS BUILT SKETCH

I understand that this permit can be suspended or revoked if any false information is supplied toward securing the permit/any unauthorized changes are made to the site/any unauthorized changes are made in the installation of the system. Improvement Permit is valid for 60 months from date of issuance.

Signed: FAX EWTO 704-633-7898

Improvement Permit by: Wesley Sparks RS. date 9/14/93

Existing System Inspection by: date

Installed by: Rowan Septic Tank

Certificate of Completion by: Wesley Sparks RS date 12/21/93

Operation Permit by: Wesley Sparks RS. date 12/21/93

HEALTH DEPT. COPY: WHITE INSPECTION COPY (FINAL): GREEN OWNER COPY (FINAL): YELLOW INSPECTION COPY (INITIAL): PINK OWNER COPY (INITIAL): GOLD