IREDELL COUNTY HEALTH DEPARTMENT

Rev. Form to Construct

TESVILLE 704-878-5305 — OORESVILLE 704-664-5281

IMPROVEMENT PERMIT / ~~CERTIFICATE OF COMPLETION~~ / OPERATION PERMIT / EXISTING SYSTEM INSPECTION

PROPERTY DESCRIPTION NO. 20265 DATE 6/11/97 TAX MAP NO. 4640A 52 4750 89 7192 Watershed: ☐ Yes ☒ No

OWNER OR CONTRACTOR Mel Graham PHONE: Business 552-5338 Home

ADDRESS 7701 Park Rd. Charlotte, NC. 28210

LOCATION Shumaker Rd, TL Weathers Creek Rd. TL Pheasant Run Dr. to cul de sac on (R)

SUBDIVISION Pheasant Run BLOCK / SECTION III LOT 52 LOT AREA .74c SITE CLASS. PS DESIGN FLOW 360 L.T.A.R. .35

Septic Tank: 1000 Gallons; STB 794 Date 7/14/97

Pump Tank: 1000 Gallons; PT 47 Date 6/14/97

Pump Make: Model Serial No.

Nitrification Field: No Fields 1 Square Feet 771 Linear Feet 259

No Lines 3 Trench Width 36" Max Trench Bottom Depth 32" Gravel Depth SAND

☒ New System ☐ Repair System Type: I, II, (III) IV, V, VI

System Description: Pres Manifold to CH PLASTIC

Repair System Description: EASTERN 54, 55, 56

Maintenance Agreement Required: ☐ Yes ☐ No

☒ House/Mod. Home No. Bedrooms 3

☐ Mobile Home No. Bathrooms 3

☐ Business No. Employees

☐ Other


☒ Slab ☒ Crawl Space ☐ Basement w/plumbing ☐ Basement wo/plumbing

Water Supply: ☒ Individual ☐ Community ☐ Public


Comments:

Comments:

INITIAL SITE SKETCH

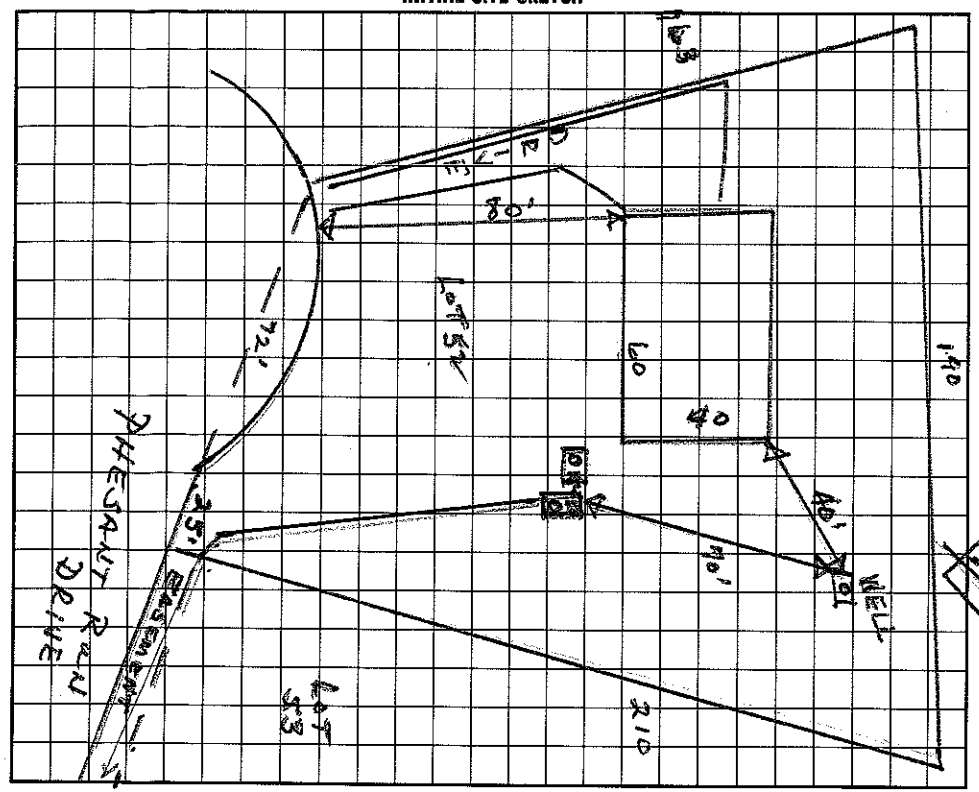

AS BUILT SKETCH

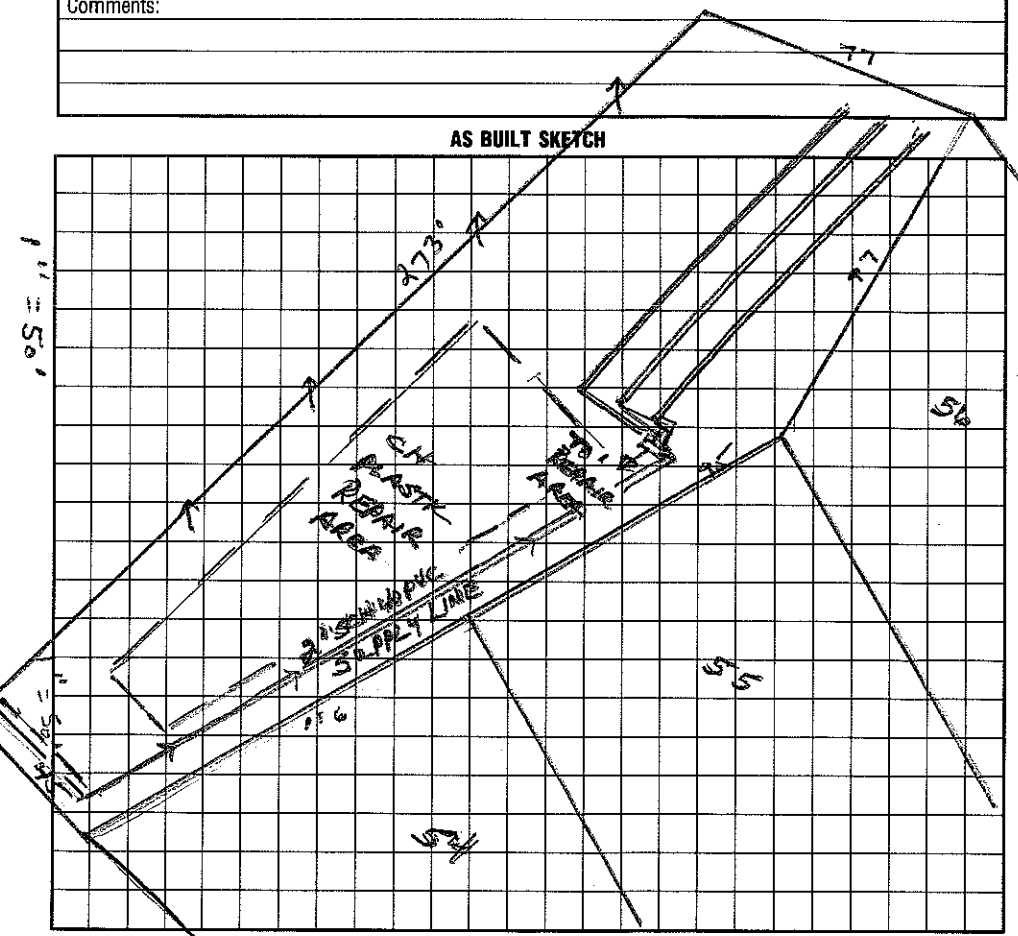

I understand that this permit can be suspended or revoked if any false information is supplied toward securing the permit/any unauthorized changes are made to the site/any unauthorized changes are made in the installation of the system. Improvement Permit is valid for 60 months from date of issuance.

Signed: Linda D. Parker

Improvement Permit by: Wesley Sparks R.S. date 6/11/97

Existing System Inspection by: Wesley Sparks R.S. date 6/11/97

Installed by: Buddy Chaney Septic Tank

Certificate of Completion by: date

Operation Permit by: C. Parker Jr. date 11/4/97

HEALTH DEPT. COPY: WHITE — INSPECTION COPY (FINAL): GREEN — OWNER COPY (FINAL): YELLOW — INSPECTION COPY (INITIAL): PINK — OWNER COPY (INITIAL): GOLD