IREDELL COUNTY HEALTH DEPARTMENT

STATESVILLE 704-878-5305 130.00 Paid MOORESVILLE 704-664-5281

IMPROVEMENT PERMIT / AUTHORIZATION TO CONSTRUCT / OPERATION PERMIT / EXISTING SYSTEM INSPECTION

PERMIT# 105557 PIN# 4750 89 9038 DATE 4/2/02

OWNER OR CONTRACTOR Fred Moore PHONE: Business 704-528-2220 Home

ADDRESS 176 Owenscash Rd. Troutman, NC 28166

LOCATION 115-21N TR Shinnville TL Weathers Creek TL Pheasant Run to first lot on R past Single Oak intersection

SUBDIVISION Pheasant Run BLOCK / SECTION 3 LOT 53 LOT AREA .77 Ac SITE CLASS. PS DESIGN FLOW 360 L.T.A.R. .3

Septic Tank: 1000 Gallons; STB 1012 Date 11/9/01
Pump Tank: Gallons; PT Date
Pump Make: Model Serial No.
Nitrification Field: No Fields 1 Square Feet 900 Linear Feet 300
No Lines 3@100' Trench Width 3' Max Trench Bottom Depth 3' Gravel Depth No

☒ New System ☐ Repair System Type: I, II, III, IV, V, VI
System Description: EZ Lay on Ch. Plastic
Repair System Description: Pressure - Type 3
Maintenance Agreement Required: ☐ Yes ☒ No

☒ House/Mod. Home No. Bedrooms 3
☐ Mobile Home No. Bathrooms 3
☐ Business No. Employees
☐ Other


☐ Slab ☒ Crawl Space ☐ Basement w/plumbing ☐ Basement wo/plumbing

Water Supply: ☒ Individual ☐ Public ☐ Community

Comments:/Conditions: Well not drilled on date of this inspection

Comments:/Conditions:

INITIAL SITE SKETCH 2/0

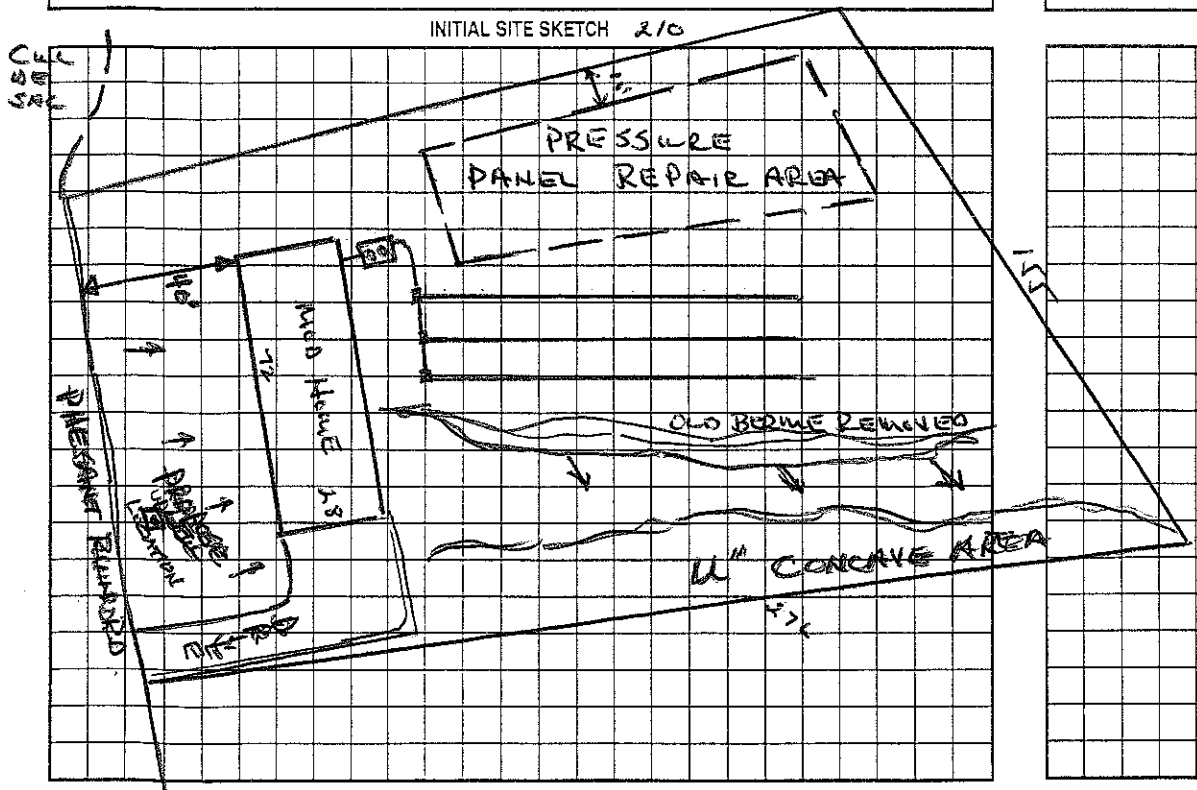

AS BUILT SKETCH

Permit can be suspended or revoked if any false information is supplied toward securing the permit/any unauthorized changes are made to the site/any unauthorized changes are made in the installation of the system. Improvement Permit with plat valid without expiration. Improvement Permit with site plan valid for sixty months. Authorization to Construct is valid for a period equal to that of Improvement Permit – not to exceed sixty months.

Signed: Dennis Dallas date 4-22

Improvement Permit by: AWS date

Authorization to Construct by: AWS date 4/2/02

Installed by: A-1 Backhoe

Operation Permit by: Wesley Sparks RS. date 4/4/02

Existing System Inspection by: date

HEALTH DEPT. COPY: WHITE OWNER COPY (FINAL): YELLOW OWNER COPY (INITIAL): PINK

IREDELL COUNTY HEALTH DEPARTMENT

STATESVILLE 704-878-5305 MOORESVILLE 704-664-5281

IMPROVEMENT PERMIT / AUTHORIZATION TO CONSTRUCT / OPERATION PERMIT / EXISTING SYSTEM INSPECTION

PERMIT# 105557 PIN# 4750-89-9038 DATE 4/2/02

OWNER OR CONTRACTOR Fred Moore PHONE: Business 704-528-2220 Home 704-528-7120 -Newton

ADDRESS 176 Owenesh Rd Trantman NC. 28166

LOCATION 115-21 N TR Shinnville Rd. TL Weathers Creek TL Pleasant Run Rd. to first lot on (R) past Single Oak intersection

SUBDIVISION Pleasant Run BLOCK / SECTION 3 LOT 53 LOT AREA .77 Ac SITE CLASS. PS DESIGN FLOW 360 L.T.A.R. .3

Septic Tank: 1000 Gallons; STB 1012 Date 11/9/01
Pump Tank: ____ Gallons; PT ____ Date ____
Pump Make: ____ Model ____ Serial No. ____
Nitrification Field: No Fields 1 Square Feet 1200 Linear Feet 400
No Lines 3@133' Trench Width 3' Max Trench Bottom Depth 34" Gravel Depth 12"

[X] New System [ ] Repair System Type: I, [II], III, IV, V, VI
System Description: Dicrete Conventional
Repair System Description: Pressure Type 3
Maintenance Agreement Required: [ ] Yes [X] No


[X] House/Mod. Home No. Bedrooms 3
[ ] Mobile Home No. Bathrooms 2
[ ] Business No. Employees ____
[ ] Other ____
[ ] Slab [X] Crawl Space [ ] Basement w/plumbing [ ] Basement wo/plumbing

Water Supply: [X] Individual [ ] Public [ ] Community


Comments:/Conditions: Any movement of home location will Result in addition of Pump and Pump Tank - Tight no Changes!

Comments:/Conditions: 300 FT CH PLASTIC INSTALLED.

INITIAL SITE SKETCH (1" = 50')

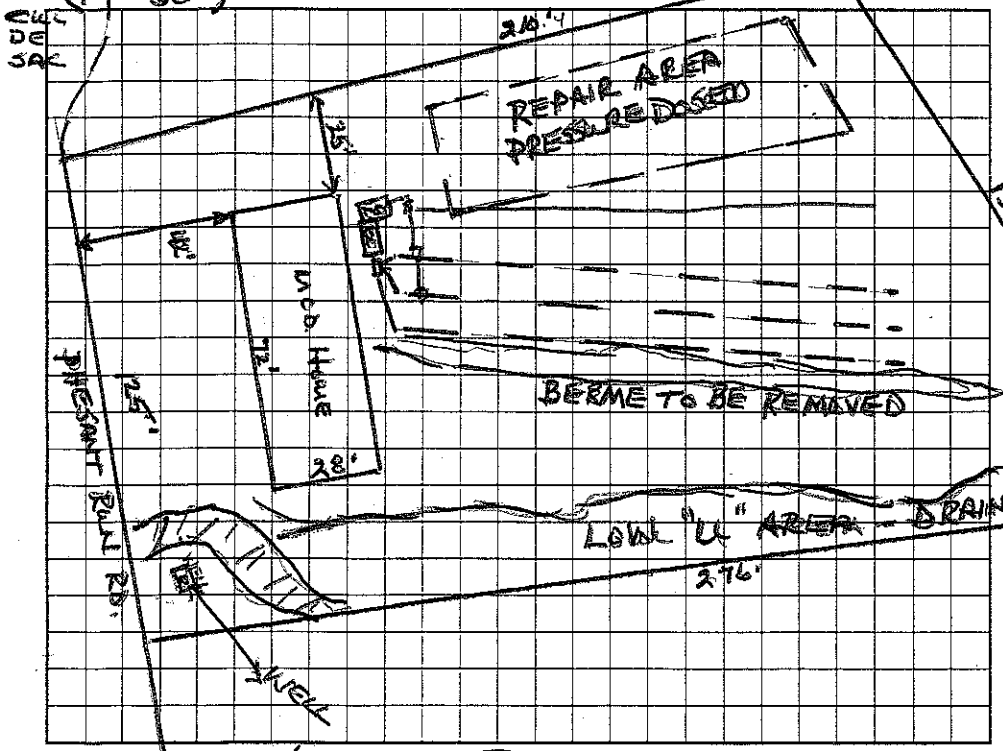

AS BUILT SKETCH

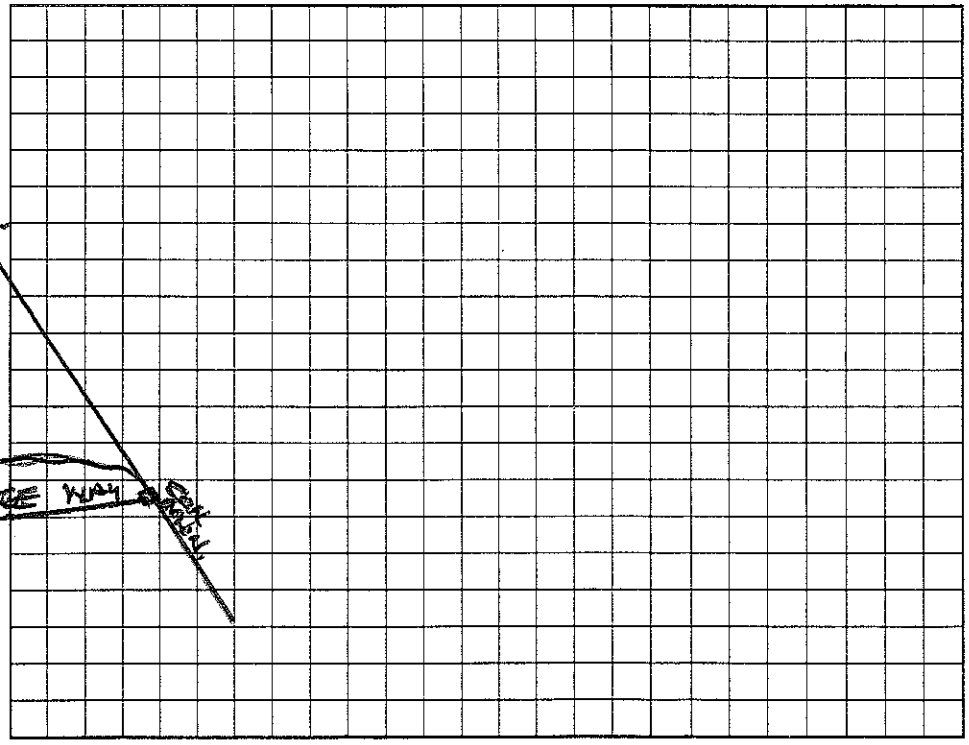

Permit can be suspended or revoked if any false information is supplied toward securing the permit/any unauthorized changes are made to the site/any unauthorized changes are made in the installation of the system. Improvement Permit with plat valid without expiration. Improvement Permit with site plan valid for sixty months. Authorization to Construct is valid for a period equal to that of Improvement Permit – not to exceed sixty months.

Signed: Teresa Tolton date 4-0302 Installed by: A-1 Backhoe

Improvement Permit by: Wesley Sparks R.S. date 4/2/02 Operation Permit by: ____ date ____

Authorization to Construct by: Wesley Sparks R.S. date 4/2/02 Existing System Inspection by: ____ date ____

HEALTH DEPT. COPY: WHITE OWNER COPY (FINAL): YELLOW OWNER COPY (INITIAL): PINK