4750953551

IREDELL COUNTY HEALTH DEPARTMENT

STATESVILLE 704-878-5305 MOORESVILLE 704-664-5281

IMPROVEMENT PERMIT / CERTIFICATE OF COMPLETION / OPERATION PERMIT / EXISTING SYSTEM INSPECTION

PROPERTY DESCRIPTION NO. 22375 DATE Oct. 19 '95 TAX MAP NO. 4GB24 Watershed: ☐ Yes ☐ No

OWNER OR CONTRACTOR South Iredell AME Zion Church PHONE: Business _____ Home _____

ADDRESS _____

LOCATION Stinnette Rd. TL Weathers Creek Rd TL Winford Rd. at end on left

SUBDIVISION _____ BLOCK / SECTION _____ LOT _____ LOT AREA Existing SITE CLASS. P5 DESIGN FLOW ~200gpd L.T.A.R. .3-.4

Septic Tank: Existing Gallons; STB Tp 1012 Date 2-26-96
Pump Tank: 1000 Gallons; PT _____ Date _____
Pump Make: _____ Model _____ Serial No. _____
Nitrification Field: No Fields 1 Square Feet 600 Linear Feet 200
No Lines 5 Trench Width 36" Max Trench Bottom Depth ≈36" Gravel Depth 12"

☐ New System ☑ Repair System Type: I, II, III, IV, V, VI
System Description: 4yr: conventional
Repair System Description: same
Maintenance Agreement Required: ☐ Yes ☐ No
☑ Slab ☐ Crawl Space ☐ Basement w/plumbing ☐ Basement wo/plumbing


☐ House/Mod. Home No. Bedrooms _____
☐ Mobile Home No. Bathrooms _____
☐ Business No. Employees _____
☑ Other Church ~40 members

Water Supply: ☑ Individual ☐ Community ☐ Public


Comments: If existing septic tank is in poor condition replace w/ present 1000gal tank.

Comments: Old building unrepairable - replaced w/ new building

INITIAL SITE SKETCH

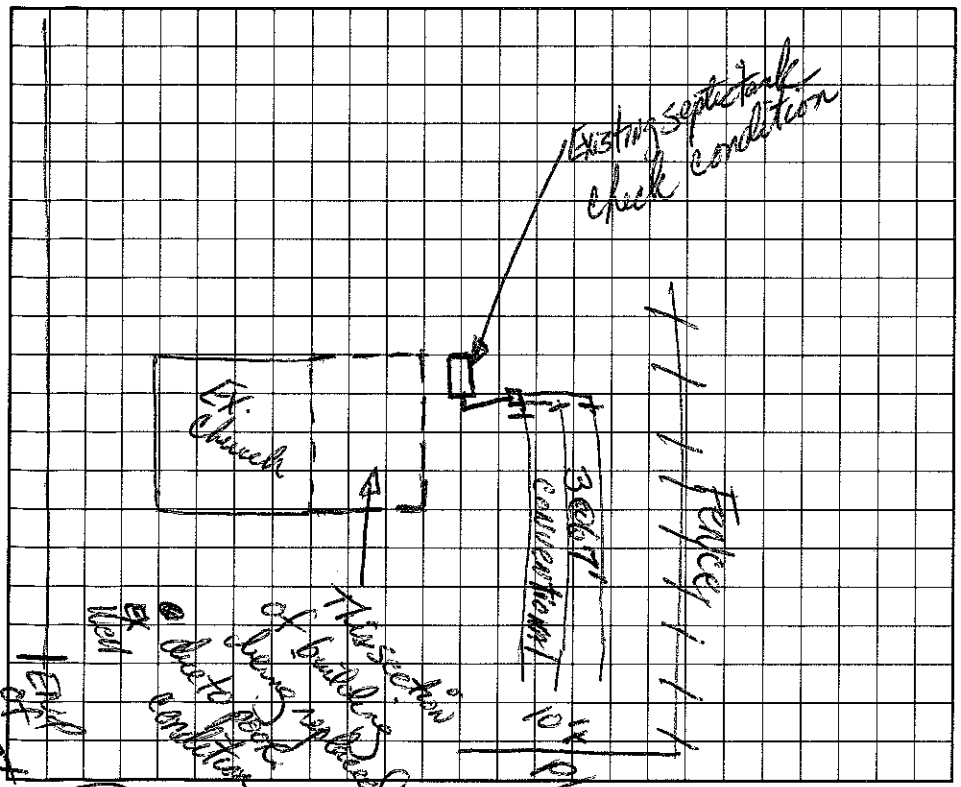

AS BUILT SKETCH

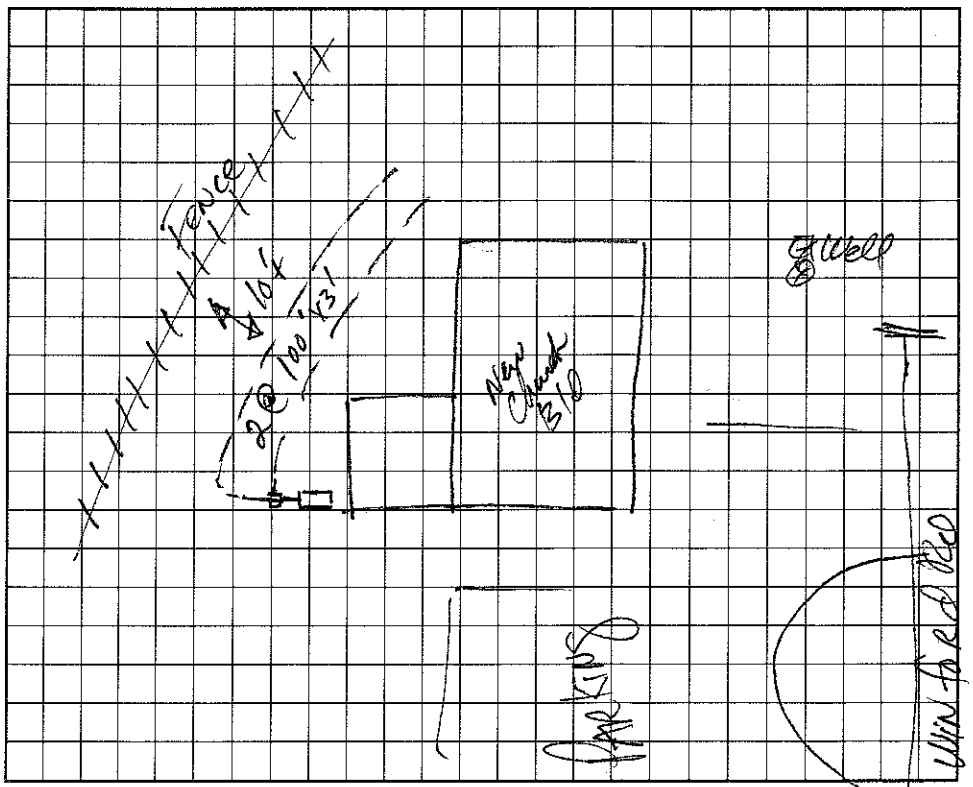

I understand that this permit can be suspended or revoked if any false information is supplied toward securing the permit/any unauthorized changes are made to the site/any unauthorized changes are made in the installation of the system.

Signed: _____

Improvement Permit by: _____ date 10/19/95

Authority to construct

Existing System Inspection by: _____ date 10/19/95

Installed by: Forest Stanford

Certificate of Completion by: _____ date _____

Operation Permit by: _____ date 4-19-96

HEALTH DEPT. COPY: WHITE INSPECTION COPY (FINAL): GREEN OWNER COPY (FINAL): YELLOW INSPECTION COPY (INITIAL): PINK OWNER COPY (INITIAL): GOLD