4750965583

IREDELL COUNTY HEALTH DEPARTMENT

Construction Auth. STATESVILLE 704-878-5305 MOORESVILLE 704-664-5281

IMPROVEMENT PERMIT / ~~CERTIFICATE OF COMPLETION~~ / OPERATION PERMIT / EXISTING SYSTEM INSPECTION

PROPERTY DESCRIPTION NO. 21384 DATE March 14, '96 TAX MAP NO. 4GB35 Watershed: [ ] Yes [X] No

OWNER OR CONTRACTOR Robert Cowan PHONE: Business _____ Home _____

ADDRESS 450 Weathers Creek Rd. / Troutman

LOCATION 115-21N TR Shinnville Rd. TL Weathers Creek Rd. TL Winford Rd. ½-¼ mile on Right

SUBDIVISION _____ BLOCK / SECTION _____ LOT _____ LOT AREA 2.5Ac SITE CLASS PS DESIGN FLOW 480gpd L.T.A.R. .3

Septic Tank: 1000 Gallons; STB 321 Date 2-14-96
Pump Tank: _____ Gallons; PT _____ Date _____
Pump Make: _____ Model _____ Serial No. _____
Nitrification Field: No Fields 1 Square Feet 1620 Linear Feet 540
No Lines 3@180' Trench Width 36" Max Trench Bottom Depth 36"

[X] New System [ ] Repair System Type: I [X] II III IV V VI
System Description: gravity, conventional
Repair System Description: same
Maintenance Agreement Required: [ ] Yes [X] No
Gravel Depth 12"

[ ] House/Mod. Home [ ] Mobile Home [ ] Business [ ] Other
No. Bedrooms 4 No. Bathrooms 2 No. Employees _____


[ ] Slab [X] Crawl Space [ ] Basement w/plumbing [ ] Basement wo/plumbing

Water Supply: [ ] Individual [ ] Community [ ] Public


Comments:

Comments:

INITIAL SITE SKETCH

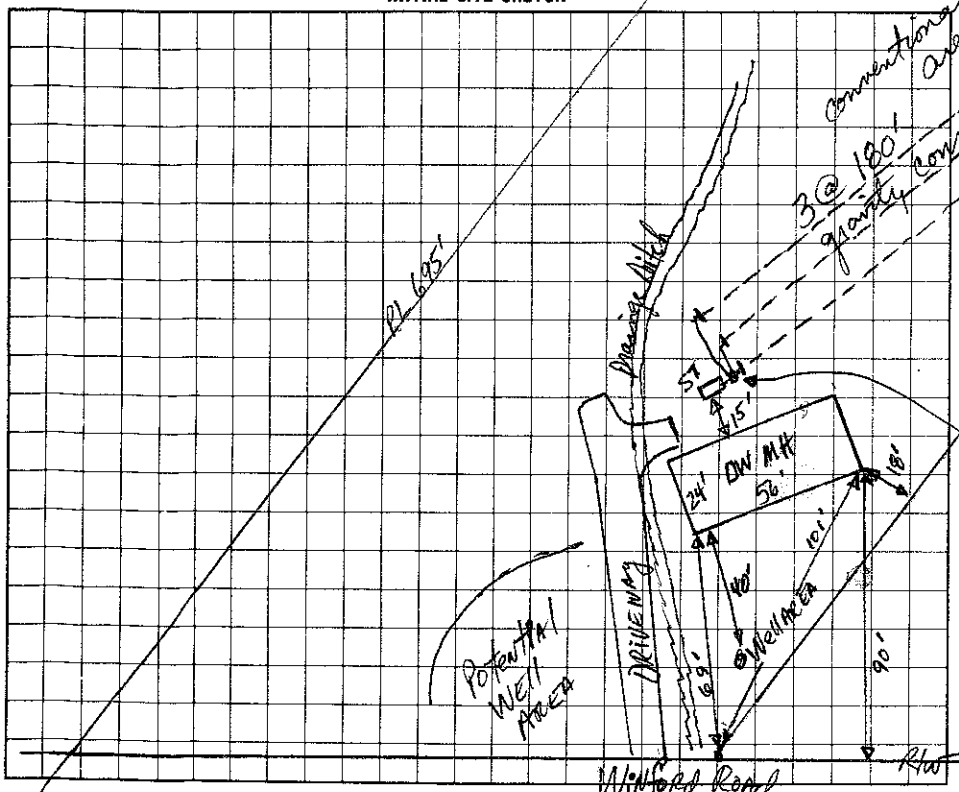

AS BUILT SKETCH

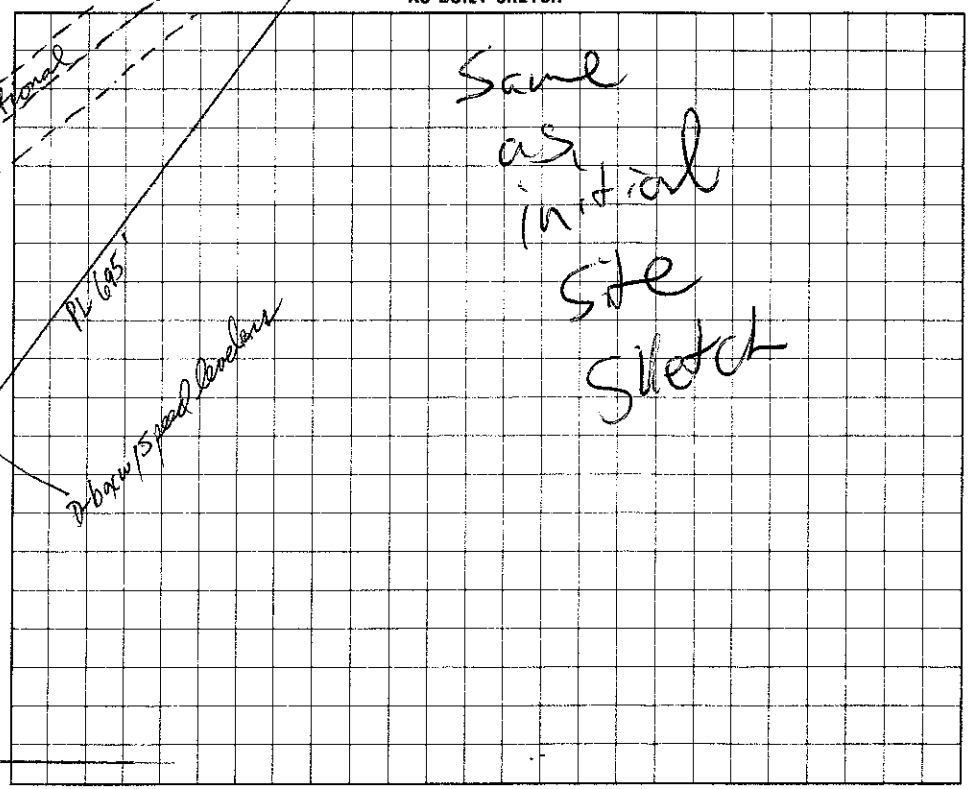

I understand that this permit can be suspended or revoked if any false information is supplied toward securing the permit/any unauthorized changes are made to the site/any unauthorized changes are made in the installation of the system.

Signed: Robert Cowan 3-14-96 Installed by: G+M Enterprises

Improvement Permit by: _____ date 3-14-96 Certificate of Completion by: _____ date _____

Existing System Inspection by: _____ date 3-14-96 Operation Permit by: _____ date 3/25/96

Construction Authorization

HEALTH DEPT. COPY: WHITE INSPECTION COPY (FINAL): GREEN OWNER COPY (FINAL): YELLOW INSPECTION COPY (INITIAL): PINK OWNER COPY (INITIAL): GOLD