IREDELL COUNTY HEALTH DEPARTMENT

Correction to Construct (9:30) 735-2314 - Cody Wright

STATESVILLE 704-878-5305 MOORESVILLE 704-664-5281

IMPROVEMENT PERMIT / CERTIFICATE OF COMPLETION / OPERATION PERMIT / EXISTING SYSTEM INSPECTION

PROPERTY DESCRIPTION NO. 24457 DATE 8/2/96 TAX MAP NO. 4G B 48 Watershed: ☐ Yes ☒ No

OWNER OR CONTRACTOR Jacqueline Westmoreland PHONE: Business 4750-97-9179 Home 528-3243

ADDRESS 402 Weathers Creek Rd. Troutman, NC. 28166

LOCATION Shingle TR Weathers Creek on (L) just Overcash Rd.

SUBDIVISION N/A BLOCK / SECTION ____ LOT ____ LOT AREA 1.64 AC SITE CLASS. PS. DESIGN FLOW 360 L.T.A.R. .3

Septic Tank: 1000 Gallons; STB 794 Date 4/25/96

Pump Tank: 1000 Gallons; PT 29 Date ~~4/25/96~~ 7/26/96

Pump Make: ____ Model ____ Serial No. ____

Nitrification Field: No Fields 3 Square Feet 1200 Linear Feet 400

No Lines 3 Trench Width 36" Max Trench Bottom Depth 36" Gravel Depth 12"

☒ New System ☐ Repair System Type: I, II, (III), IV, V, VI

System Description: Pump Mon - Conventional

Repair System Description: None

Maintenance Agreement Required: ☐ Yes ☐ No

☒ House/Mod. Home No. Bedrooms 3

☐ Mobile Home No. Bathrooms 2

☐ Business No. Employees ____

☐ Other ____


☐ Slab ☒ Crawl Space ☐ Basement w/plumbing ☐ Basement wo/plumbing

Water Supply: ☒ Individual ☐ Community ☐ Public


Comments:

Comments: LINES TANKS Checked 8/30/96
PRESSURE & ALARM checked 9/24/96
- NEMA 4X BOX NOT CORRECT.

INITIAL SITE SKETCH

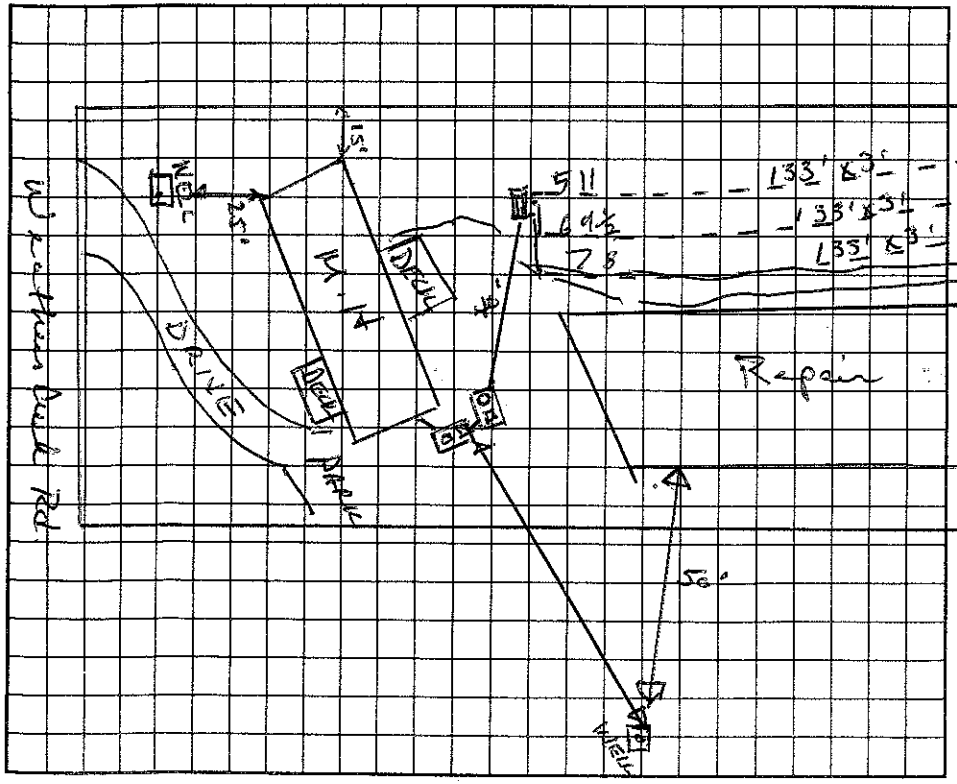

AS BUILT SKETCH

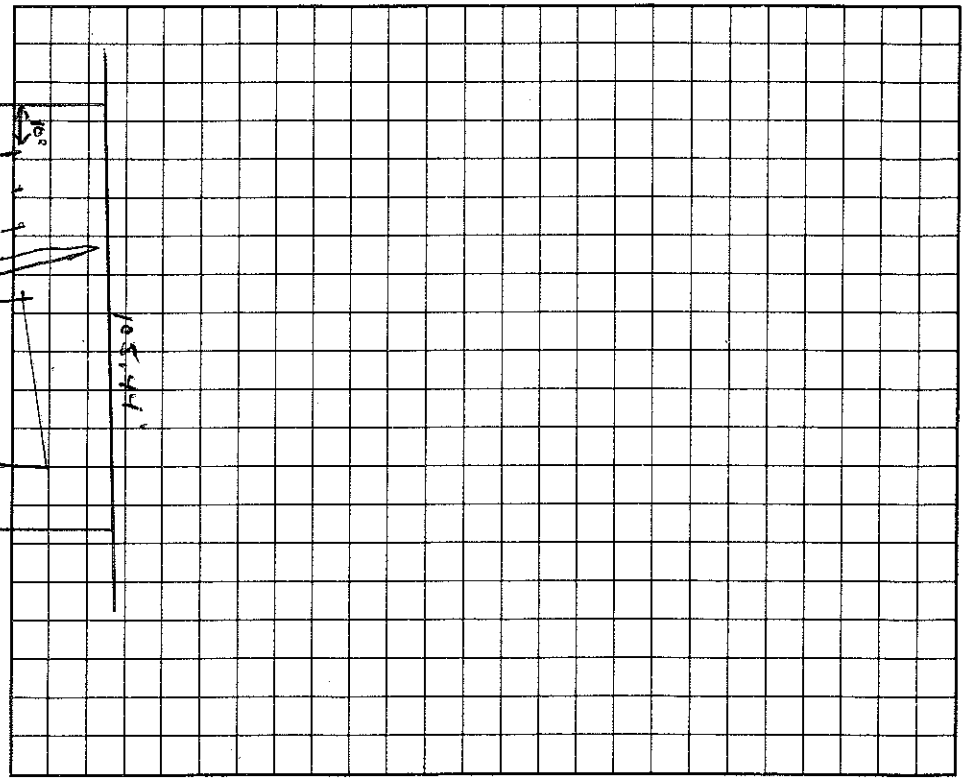

I understand that this permit can be suspended or revoked if any false information is supplied toward securing the permit/any unauthorized changes are made to the site/any unauthorized changes are made in the installation of the system.

Signed: Paula Millis

Improvement Permit by: Wesley Sparks R.S. date 8/2/96

Existing System Inspection by: Wesley Sparks R.S. date 8/2/96

Installed by: CODYCO

Certificate of Completion by: ____ date ____

Operation Permit by: C. B. Thomas EHS date 9/25/96

HEALTH DEPT. COPY: WHITE INSPECTION COPY (FINAL): GREEN OWNER COPY (FINAL): YELLOW INSPECTION COPY (INITIAL): PINK OWNER COPY (INITIAL): GOLD