IREDELL COUNTY HEALTH DEPARTMENT

STATESVILLE 704-878-5305 MOORESVILLE 704-664-5281

IMPROVEMENT PERMIT / CERTIFICATE OF COMPLETION / OPERATION PERMIT / EXISTING SYSTEM INSPECTION

PROPERTY DESCRIPTION NO. 17010 DATE 3/28/94 TAX MAP NO. 4647A 43 Watershed: ☐ Yes ☒ No

OWNER OR CONTRACTOR MEL GRAHAM (PHESANT RUN) PHONE: Business 552-5338 ~~Home~~ 4750-98-1499

ADDRESS 7707 PARK RD. CHARLOTTE

LOCATION PHESANT RUN RD; WEATHERS CRK FROM SHINNVILLE TL PHESAN RUN, 4th LOT ON (L)

SUBDIVISION PHESANT RUN BLOCK / SECTION 2 LOT 43 LOT AREA ~1.66AC SITE CLASS. P DESIGN FLOW 360 L.T.A.R. .3

Septic Tank: 1000 Gallons; STB 1025 Date 5/20/94

Pump Tank: ____ Gallons; PT ____ Date ____

Pump Make: ____ Model ____ Serial No. ____

Nitrification Field: No Fields 1 Square Feet 1200 Linear Feet 400

No Lines 4 Trench Width 36" Max ~~Trench~~ Bottom Depth 36" Gravel Depth 12"

☒ New System ☐ Repair System Type: I (II) III, IV, V, VI

System Description: CONV - DIST BOX

Repair System Description: SAME

Maintenance Agreement Required: ☐ Yes ☒ No

☒ House/Mod. Home No. Bedrooms 3

☐ Mobile Home No. Bathrooms 2

☐ Business No. Employees ____

☐ Other ____

☐ Slab ☒ Crawl Space ☐ Basement w/plumbing ☐ Basement wo/plumbing


Water Supply: ☒ Individual ☐ Community ☐ Public

Comments:

TRENCH DEPTH 36"

PRIVACY BERM SMOOTH OFF TERRACE

INITIAL SITE SKETCH

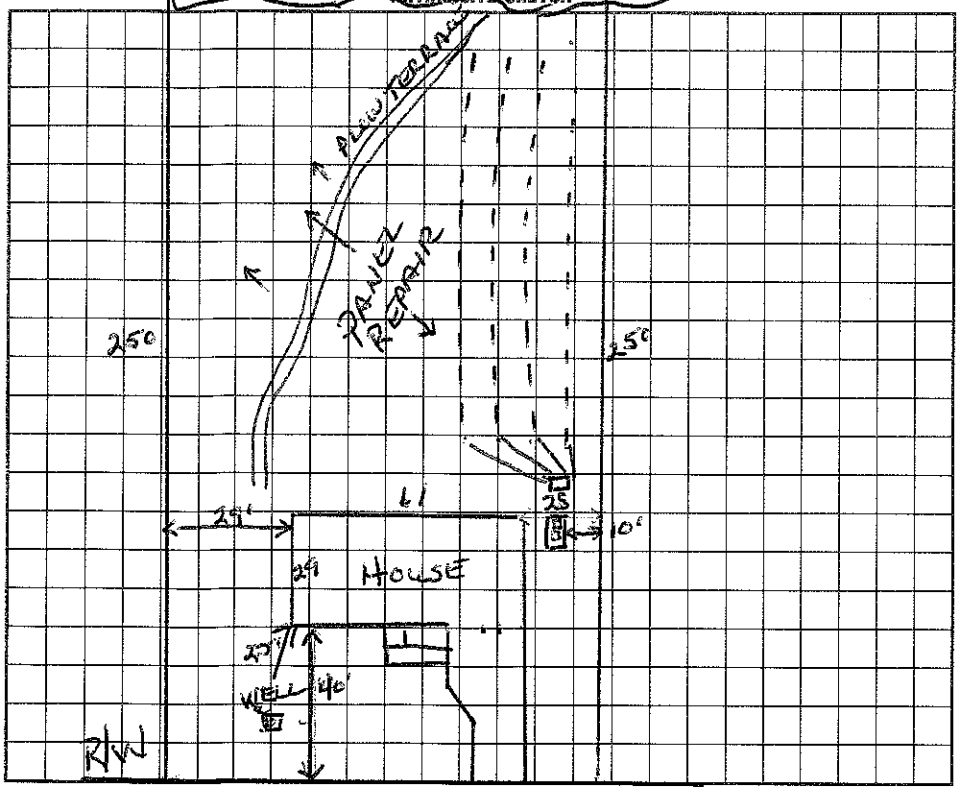

Comments:

installed as shown

AS BUILT SKETCH

I understand that this permit can be suspended or revoked if any false information is supplied toward securing the permit/any unauthorized changes are made to the site/any unauthorized changes are made in the installation of the system. Improvement Permit is valid for 60 months from date of issuance.

Signed: I Daniel P Fisher - jlm

Improvement Permit by: Wesley Sparks R.S. date 3/28/94

Existing System Inspection by: ____ date ____

Installed by: Rawco Septic Tank

Certificate of Completion by: Wesley Sparks R.S. date 7/14/94

Operation Permit by: ____ date ____

HEALTH DEPT. COPY: WHITE INSPECTION COPY (FINAL): GREEN OWNER COPY (FINAL): YELLOW INSPECTION COPY (INITIAL): PINK OWNER COPY (INITIAL): GOLD