IREDELL COUNTY HEALTH DEPARTMENT

STATESVILLE 704-878-5305 MOORESVILLE 704-664-5281

IMPROVEMENT PERMIT / CERTIFICATE OF COMPLETION / OPERATION PERMIT / EXISTING SYSTEM INSPECT.

PROPERTY DESCRIPTION NO. 17009 DATE 9/17/93 TAX MAP NO. 4G 4A 44

OWNER OR CONTRACTOR MEL GRAHAM INC (CARROL FISHER CONST.) PHONE: Business 552-5338 Home 4750-98-1506

ADDRESS PARK RD. CHARLOTTE, NC.

LOCATION PHESANT RUN RD.

SUBDIVISION PHESANT RUN BLOCK / SECTION III LOT 44 LOT AREA .66 AC SITE CLASS. P L.T.A.R. .25-.3

Water Supply: ☑ Individual ☐ Community ☐ Public

Septic Tank: 1000 Gallons; STB 825 Date 10/2/93

Pump Tank: _____ Gallons; PT _____ Date _____

Nitrification Fields: No Fields 1 Square Feet 1200 Linear Feet 400

No Lines ~~4~~ 3 Trench Width 3' Trench Depth ~~30"~~ 30" Gravel Depth ~~36"~~ 12" AWS

☑ New System ☐ Repair System Type: I, (II), II, IV, V, VI

System Description: CONV.

Repair System Description: CONV.

Maintenance Agreement Required: ☐ Yes ☑ No

☑ House/Mod. Home ☐ Mobile Home ☐ Business ☐ Other

No. Bedrooms 3 No. Bathrooms 2 No. Employees _____

☑ Slab ☐ Crawl Space ☐ Basement w/plumbing ☐ Basement wo/plumbing

Garbage Disposal: ☐ Yes ☑ No

Auto. Dishwasher: ☑ Yes ☐ No


Auto. Washing Machine: ☑ Yes ☐ No

Other _____

Comments TRENCH DEPTH 30" TO TRENCH DEPTH. PLUMBING MUST BE SHALLOW IN ORDER TO SHALLOW TRENCHES UP.

105, 95, 95, 105 x 3'

INITIAL SITE SKETCH

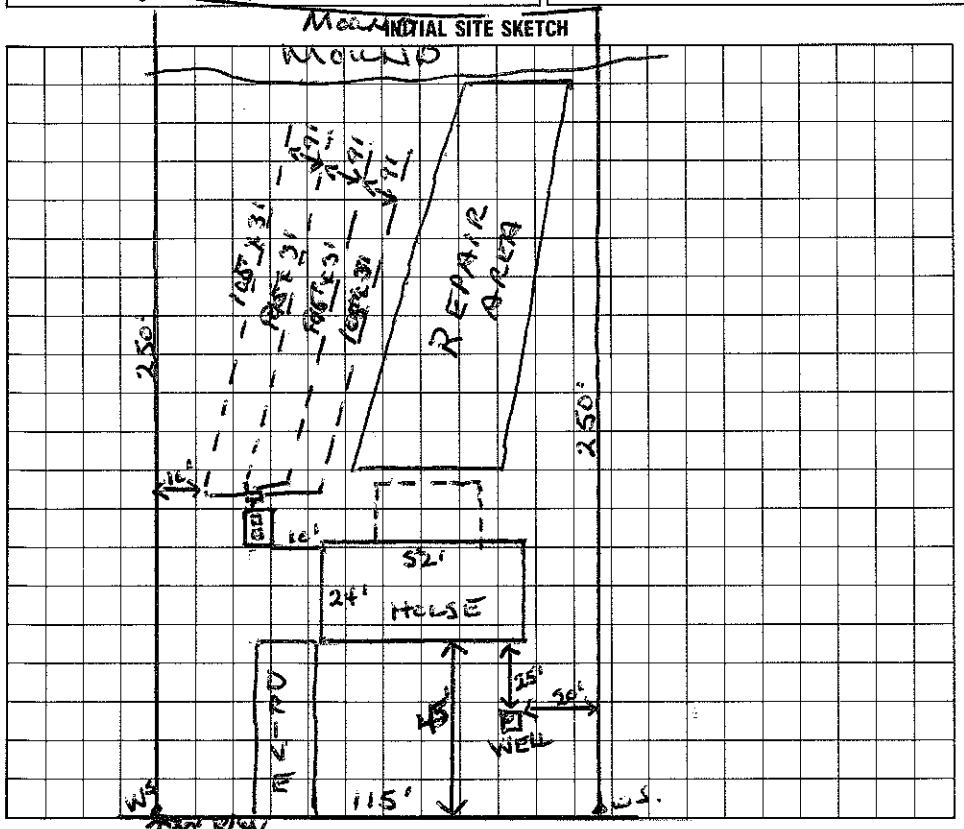

AS BUILT SKETCH

Installed as shown 11/4/93

Well not drilled on this date

I understand that this permit can be suspended or revoked if any false information is supplied toward securing the permit/any unauthorized changes are made to the site/any unauthorized changes are made in the installation of the system. Improvement Permit is valid for 60 months from date of issuance.

Signed: CARROL FISHER CONST.

Improvement Permit by: Wesley Sparks RS. date 9/20/93

Existing System Inspection by: _____ date _____

Installed by: ROWAN SEPTIC TANK

Certificate of Completion by: Wesley Sparks RS. date 11/4/93

Operation Permit by: _____ date _____

HEALTH DEPT. COPY: WHITE INSPECTION COPY (FINAL): GREEN OWNER COPY (FINAL): YELLOW INSPECTION COPY (INITIAL): PINK OWNER COPY (INITIAL): GOLD