IREDELL COUNTY HEALTH DEPARTMENT

STATESVILLE 704-878-5305 MOORESVILLE 704-664-5281

IMPROVEMENT PERMIT / CERTIFICATE OF COMPLETION / OPERATION PERMIT / EXISTING SYSTEM INSPECTION

PROPERTY DESCRIPTION NO. 16906 DATE 8/27/93 TAX MAP NO. 4644 36

OWNER OR CONTRACTOR MEL GRAHAM ENT. ~~PHONE: Business~~ 4750-98-3810 Home 552-5538

ADDRESS 7707 PARK RD. CHARLOTTE, NC.

LOCATION WEATHERS CRK RD, TL ON PHESANT RUN RD, ON R CORNER OF INTERSECT WITH SINGLE OAK DR.

SUBDIVISION PHESANT RUN BLOCK / SECTION III LOT 36 LOT AREA .66 AC SITE CLASS. P L.T.A.R. .25-.3

Water Supply: ☑ Individual ☐ Community ☐ Public

Septic Tank: 1000 Gallons; STB 825 Date 10-5-93

Pump Tank: _____ Gallons; PT _____ Date _____

Nitrification Field: No Fields 1 Square Feet 1200 Linear Feet 400

No Lines 5 Trench Width 3' Trench Depth 3' Gravel Depth 12"

☑ New System ☐ Repair System Type: I, II, III, IV, V, VI

System Description: CONV.

Repair System Description: CONV.

Maintenance Agreement Required: ☐ Yes ☑ No

☑ House/Mod. Home No. Bedrooms 3 Garbage Disposal: ☐ Yes ☑ No

☐ Mobile Home No. Bathrooms 2 Auto. Dishwasher: ☑ Yes ☐ No

☐ Business No. Employees _____ Auto. Washing Machine: ☑ Yes ☐ No


☐ Other _____ Other _____

☑ Slab ☐ Crawl Space ☐ Basement w/plumbing ☐ Basement wo/plumbing

Comments TRENCHES ON SLOPE CONTOUR IN DIRECTION SHOWN HERE.
TRENCH DEPTH MAY NOT EXCEED 36" TO TRENCH BOTTOM.

DROP BOXES

INITIAL SITE SKETCH

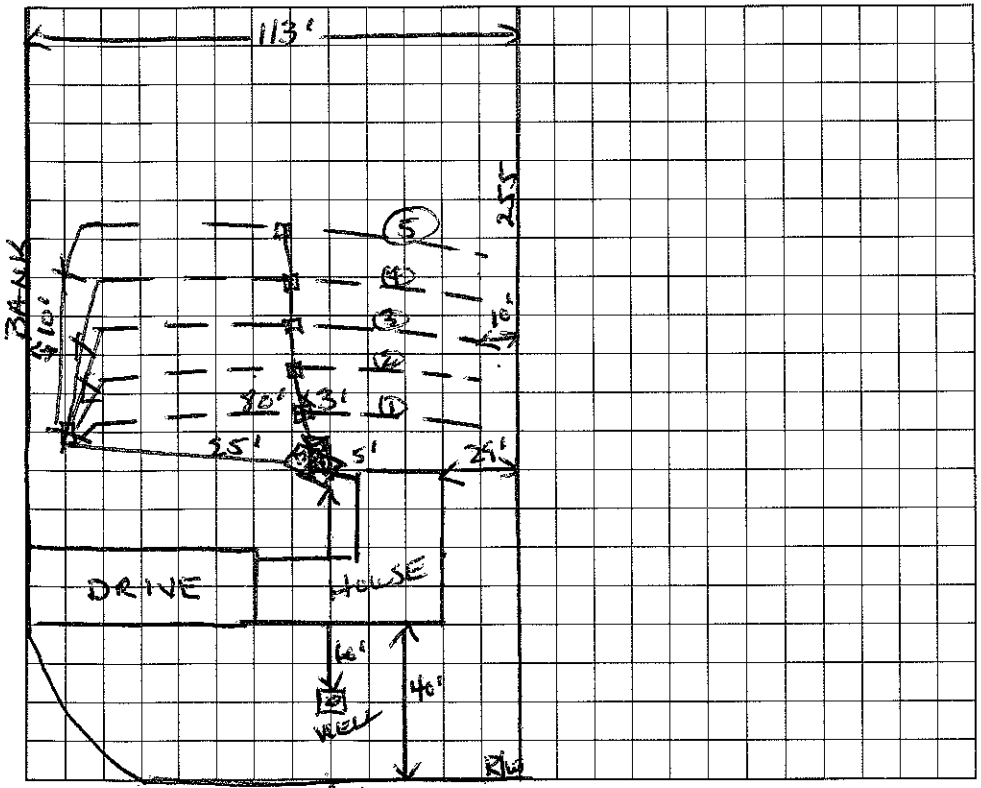

AS BUILT SKETCH

INSTALLED AS DRAWN.
AWS.

I understand that this permit can be revoked if any false information is supplied toward securing the permit/any unauthorized changes are made to the site/any unauthorized changes are made in the installation of the system. Improvement Permit is valid for 60 months from date of issuance.

Signed: _____

Improvement Permit by: Wesley Sparks RS. date 8/30/93

Existing System Inspection by: _____ date _____

Installed by: Rowan Septic Tank Co.

Certificate of Completion by: Wesley Sparks RS. date 11/15/93

Operation Permit by: _____ date _____

HEALTH DEPT. COPY: WHITE INSPECTION COPY (FINAL): GREEN OWNER COPY (FINAL): YELLOW INSPECTION COPY (INITIAL): PINK OWNER COPY (INITIAL): GOLD