IREDELL COUNTY HEALTH DEPARTMENT

Authorization to Construct

STATESVILLE 704-878-5305 MOORESVILLE 704-664-5281

IMPROVEMENT PERMIT / ~~CERTIFICATE OF COMPLETION~~ / OPERATION PERMIT / EXISTING SYSTEM INSPECTION

PROPERTY DESCRIPTION NO. 21984 DATE 12/20/95 TAX MAP NO. 4G 4A 39

OWNER OR CONTRACTOR Mel Graham PHONE: Business 663-6905 ~~Home~~ 4750-98-5515 Watershed: ☐ Yes ☒ No

ADDRESS 7701 Park Rd. Charlotte, NC.

LOCATION Weathers Creek Rd, TL Pheasant Run Rd, 2nd lot on (R)

SUBDIVISION Pheasant Run BLOCK / SECTION III LOT 39 LOT AREA .94 AC SITE CLASS. P5 DESIGN FLOW 360 L.T.A.R. .3

Septic Tank: 1000 Gallons; STB 97 Date 2/24/98

Pump Tank: _____ Gallons; PT _____ Date _____

Pump Make: _____ Model _____ Serial No. _____

Nitrification Field: No Fields 1 Square Feet 1200 Linear Feet ~~X~~ 300

No Lines 4 Trench Width 36" Max Trench Bottom Depth 36" Gravel Depth N/A

☒ New System ☐ Repair System Type: I, II, (III) IV, V, VI

System Description: GRAVITY INFILTRATOR

Repair System Description: 16" Prefab Panels

Maintenance Agreement Required: ☐ Yes ☒ No

☒ House/Mod. Home ☐ Mobile Home ☐ Business ☐ Other

No. Bedrooms 3 No. Bathrooms 2 No. Employees _____


☐ Slab ☒ Crawl Space ☐ Basement w/plumbing ☐ Basement wo/plumbing

Water Supply: ☒ Individual ☐ Community ☐ Public


Comments: ~~X~~ 25% reduction for infiltrator use
4 @ 75' x 3'
Sand required to backfill around louvers

Comments:
7/15/98 MAY ADD GARAGE ON (L) SIDE OF HOUSE SEE ATTACHED FAX - AWS.
J-S Ready Mix 1471 Hwy 5 Kingstree SC 29720

INITIAL SITE SKETCH

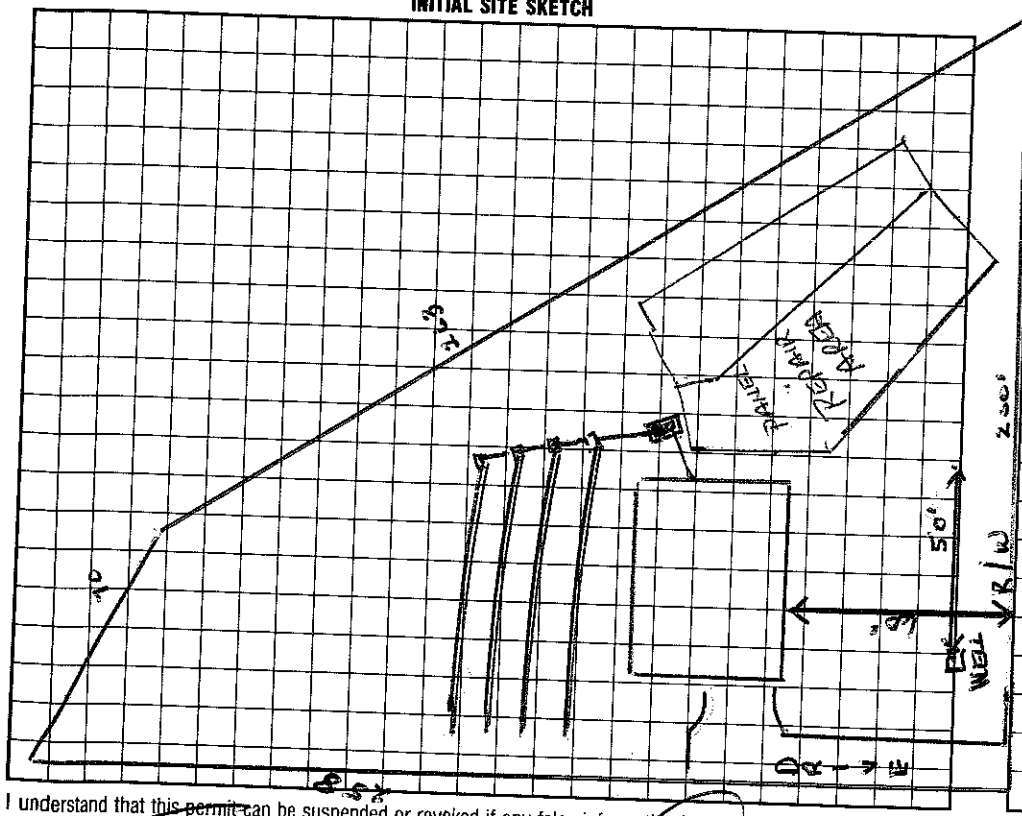

AS BUILT SKETCH

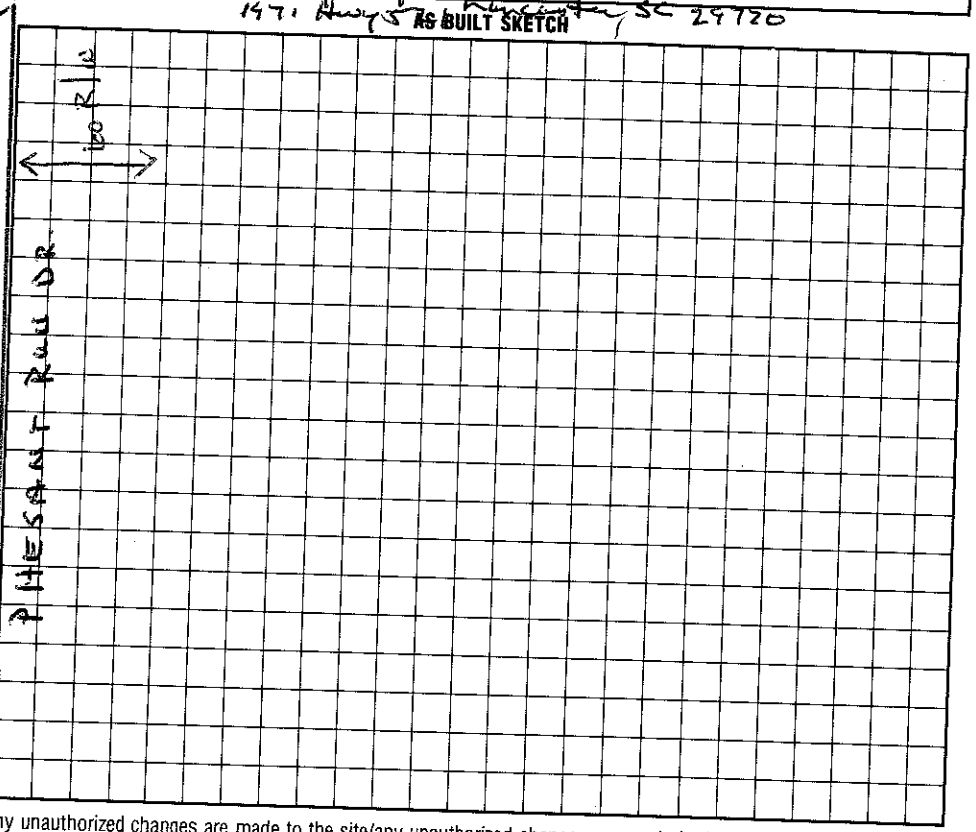

I understand that this permit can be suspended or revoked if any false information is supplied toward securing the permit/any unauthorized changes are made to the site/any unauthorized changes are made in the installation of the system.

Signed: Tony Parker Agent

Improvement Permit by: Wesley Sparks R.S. date 12/20/95

~~Existing System Inspection by:~~ Tony Parker Agent / Wesley Sparks R.S. date 12/20/95

Installed by: WT Norwood

Certificate of Completion by: _____ date _____

Operation Permit by: Wesley Sparks R.S. date 9/17/98

HEALTH DEPT. COPY: WHITE | INSPECTION COPY (FINAL): GREEN | OWNER COPY (FINAL): YELLOW | INSPECTION COPY (INITIAL): PINK | OWNER COPY (INITIAL): GOLD