IREDELL COUNTY HEALTH DEPARTMENT Authorization to Construct

STATESVILLE 704-878-5305 MOORESVILLE 704-664-5281

IMPROVEMENT PERMIT / ~~CERTIFICATE OF COMPLETION~~ / OPERATION PERMIT / EXISTING SYSTEM INSPECTION

PROPERTY DESCRIPTION NO. 067819 DATE 7/14/97 TAX MAP NO. 4750985946 Watershed: ☐ Yes ☒

OWNER OR CONTRACTOR Mel Graham PHONE: Business JACOBS - 663-6905 Home

ADDRESS 6100 Fairview Suite 810 Charlotte NC. 28210

LOCATION Shinnville Rd TL Weathers Creek TR Single Oak Dr. to 6th on (L)

SUBDIVISION Pheasant Run BLOCK / SECTION III LOT 34 LOT AREA .63 SITE CLASS. PS DESIGN FLOW 360 L.T.A.R. .3

Septic Tank: 1000 Gallons; STB 354 Date 11/26/01

Pump Tank: Gallons; PT Date

Pump Make: Model Serial No.

Nitrification Field: No Fields 1 Square Feet 1200 Linear Feet 400

No Lines 5 Trench Width 36" Max Trench Bottom Depth 36" Gravel Depth 12"

☒ New System ☐ Repair System Type: I, (II), III, IV, V, VI

System Description: CONVENTIONAL

Repair System Description: SAME

Maintenance Agreement Required: ☐ Yes ☒ No

☒ House/Mod. Home No. Bedrooms 3

☐ Mobile Home No. Bathrooms 2

☐ Business No. Employees

☐ Other


☐ Slab ☒ Crawl Space ☐ Basement w/plumbing ☐ Basement wo/plumbing

Water Supply: ☒ Individual ☐ Community ☐ Public


Comments:

Comments:

INITIAL SITE SKETCH

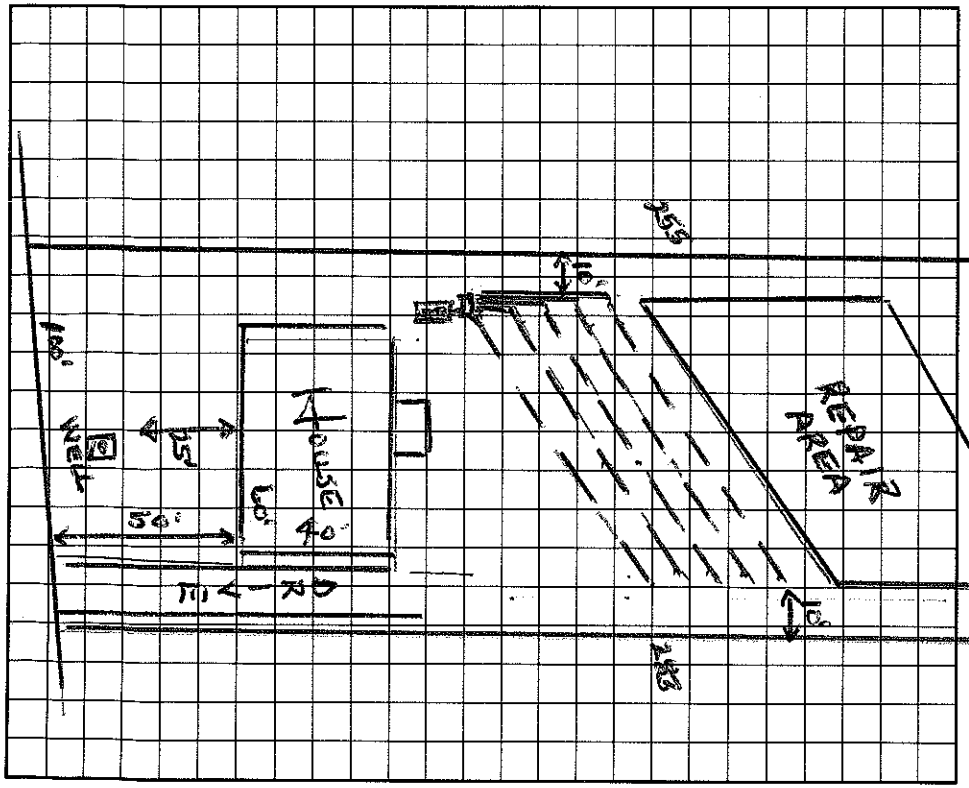

AS BUILT SKETCH

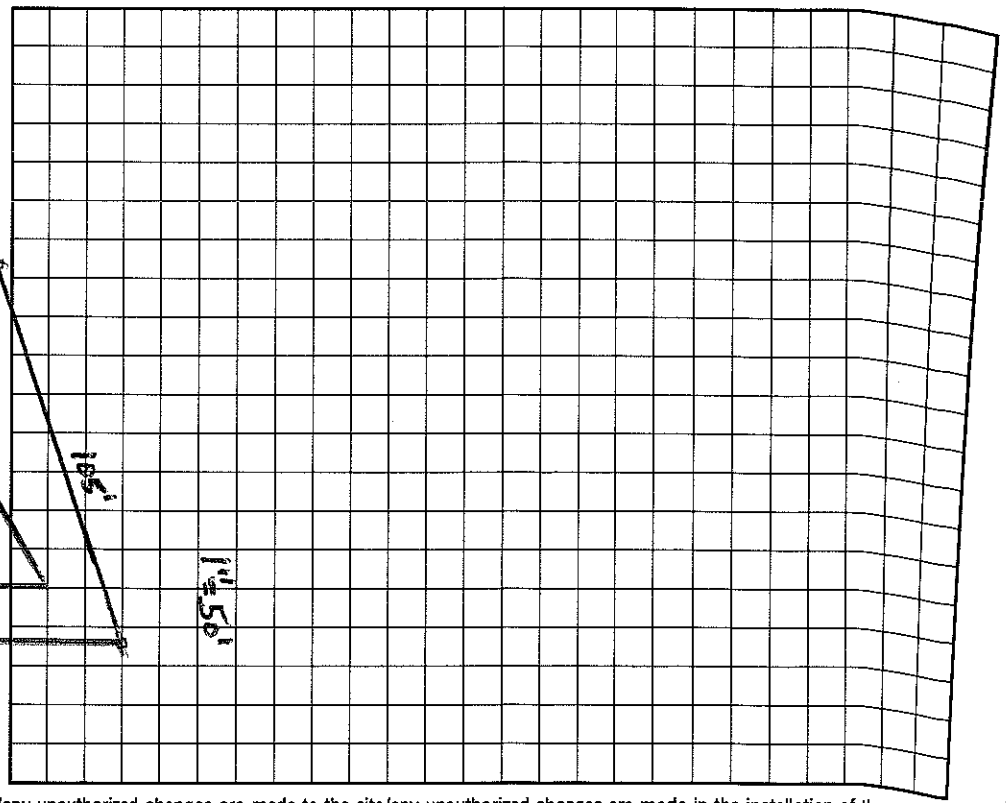

I understand that this permit can be suspended or revoked if any false information is supplied toward securing the permit/any unauthorized changes are made to the site/any unauthorized changes are made in the installation of the system. Improvement Permit is valid for ~~60~~ months from date of issuance.

Signed: James C Thompson RS Agent 7/24/97

Improvement Permit by: Wesley Sparks RS date 7/14/97

Existing System Inspection by: Wesley Sparks RS. date 7/14/97

Installed by: D+M

Certificate of Completion by: Wesley Sparks RS. date 9/19/02

Operation Permit by: Wesley Sparks RS date 9/19/02

As Built

HEALTH DEPT. COPY: WHITE INSPECTION COPY (FINAL): GREEN OWNER COPY (FINAL): YELLOW INSPECTION COPY (INITIAL): PINK OWNER COPY (INITIAL): GOLD