IREDELL COUNTY HEALTH DEPARTMENT

STATESVILLE 704-878-5305 MOORESVILLE 704-664-5281

IMPROVEMENT PERMIT / AUTHORIZATION TO CONSTRUCT / OPERATION PERMIT / EXISTING SYSTEM INSPECTION

50.00 Paid 1730

PERMIT# 119247 PIN# 4750 98 6473 DATE 3/16/04

OWNER OR CONTRACTOR Fleetwood Homes Trentmen PHONE: Business 704-528-7120 Home

ADDRESS 356 Weathers Creek Rd. Trentmon, NC 28166

LOCATION Shinnville TL Weathers Creek Rd. TL Pheasant Run Dr. corner lot on (R)

SUBDIVISION Pheasant Run BLOCK / SECTION LOT 22 LOT AREA ~1.7Ac SITE CLASS. PS DESIGN FLOW 480 L.T.A.R. .3

Septic Tank: 1000 Gallons; STB 1012 Date 10/3/03

Pump Tank: 1000 Gallons; PT 17 Date 9/22/03

Pump Make: Myers Model ME50-SP Serial No. 262 78D16

Nitrification Field: No Fields 1 Square Feet 1200 Linear Feet 400 3/04

No Lines 4@100 Trench Width 3' Max Trench Bottom Depth 3' Gravel Depth No

[X] New System [ ] Repair System Type: I, II, [III], IV, V, VI

System Description: Pressure - Type 3

Repair System Description: Same

Maintenance Agreement Required: [ ] Yes [X] No

[X] House/Mod. Home No. Bedrooms 4

[ ] Mobile Home No. Bathrooms 2

[ ] Business No. Employees


[ ] Other

[ ] Slab [X] Crawl Space [ ] Basement w/plumbing [ ] Basement wo/plumbing

Water Supply: [X] Individual [ ] Public [ ] Community

Comments:/Conditions:

INITIAL SITE SKETCH

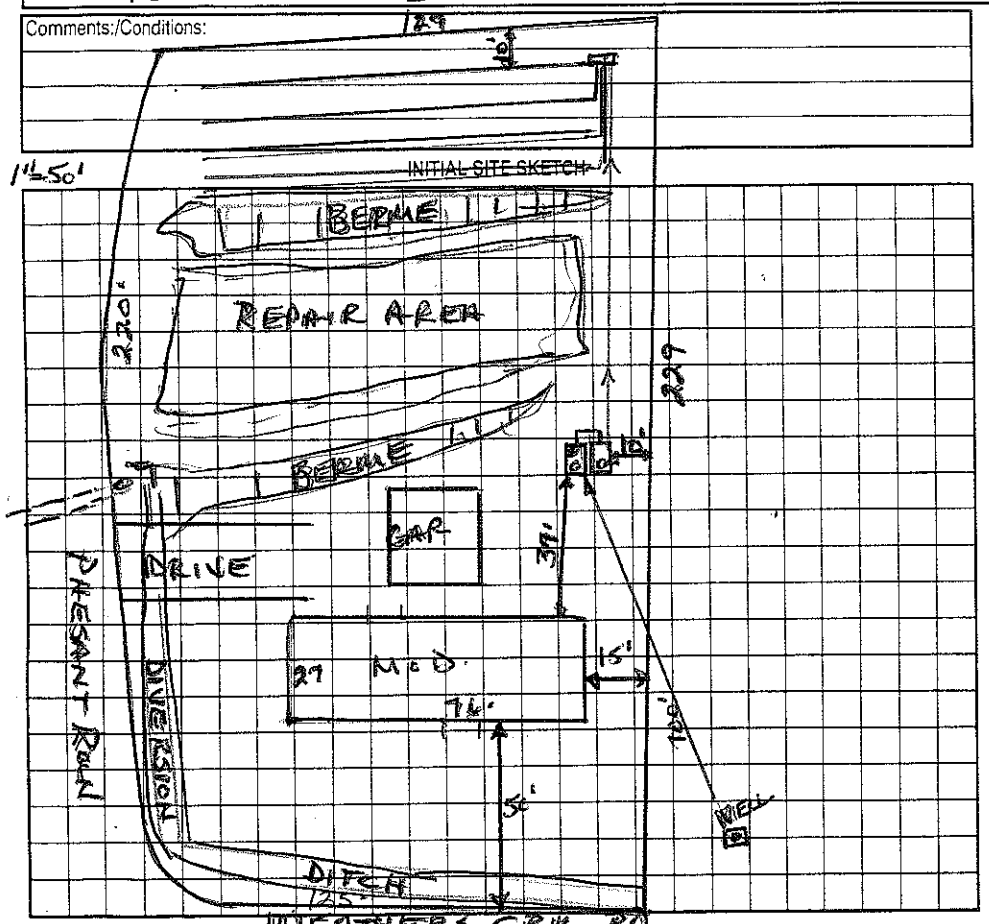

Comments:/Conditions:

AS BUILT SKETCH

4 filtrators Installed

Permit can be suspended or revoked if any false information is supplied toward securing the permit/any unauthorized changes are made to the site/any unauthorized changes are made in the installation of the system. Improvement Permit with plat valid without expiration. Improvement Permit with site plan valid for sixty months. Authorization to Construct is valid for a period equal to that of Improvement Permit – not to exceed sixty months.

Signed: [signature] 3/25/04 date

Improvement Permit by: Wesley Sparks RS. date 3/18/04

Authorization to Construct by: Wesley Sparks RS date 3/18/04

Installed by: Craig Thompson

Operation Permit by: Wesley Sparks RS. date 4/23/04

Existing System Inspection by: date

HEALTH DEPT. COPY: WHITE OWNER COPY (FINAL): YELLOW OWNER COPY (INITIAL): PINK