IREDELL COUNTY HEALTH DEPARTMENT

STATESVILLE 704-878-5305 MOORESVILLE 704-664-5281

IMPROVEMENT PERMIT / CERTIFICATE OF COMPLETION / OPERATION PERMIT / EXISTING SYSTEM INSPECTION

PROPERTY DESCRIPTION NO. 20269 DATE 6/9/95 TAX MAP NO. 4G 4A 56 Watershed: ☐ Yes ☒ No

OWNER OR CONTRACTOR Mel Graham (Pleasant Run) PHONE: Business 552-5338 ~~Home~~ 4750-99-2017

ADDRESS 7701 Park Rd. Char. NC. 28210

LOCATION Weathers Creek Rd TL Single Oak Dr. 3RD on (R) from int/section

SUBDIVISION Pleasant Run BLOCK / SECTION III LOT 56 LOT AREA .52 AC SITE CLASS. P DESIGN FLOW 360 L.T.A.R. .3

Septic Tank: 1600 Gallons; STB 829 Date 4-7-95

Pump Tank: _____ Gallons; PT _____ Date _____

Pump Make: _____ Model _____ Serial No. _____

Nitrification Field; No Fields 1 Square Feet 1200 Linear Feet ~~300~~ (400)

No Lines 4 Trench Width 36" Max Trench Bottom Depth 30" Gravel Depth N/A

☒ New System ☐ Repair System Type: I, II, (III), IV, V, VI

System Description: GRAVITY - INFILTRATOR

Repair System Description: SAME

Maintenance Agreement Required: ☐ Yes ☒ No

☒ House/Mod. Home ☐ Mobile Home ☐ Business ☐ Other

No. Bedrooms 3 No. Bathrooms 2 No. Employees ____


☐ Slab ☒ Crawl Space ☐ Basement w/plumbing ☐ Basement wo/plumbing

Water Supply: ☒ Individual ☐ Community ☐ Public

Comments: * 25% reduction for infiltrator use

Comments: Installed as shown.

INITIAL SITE SKETCH

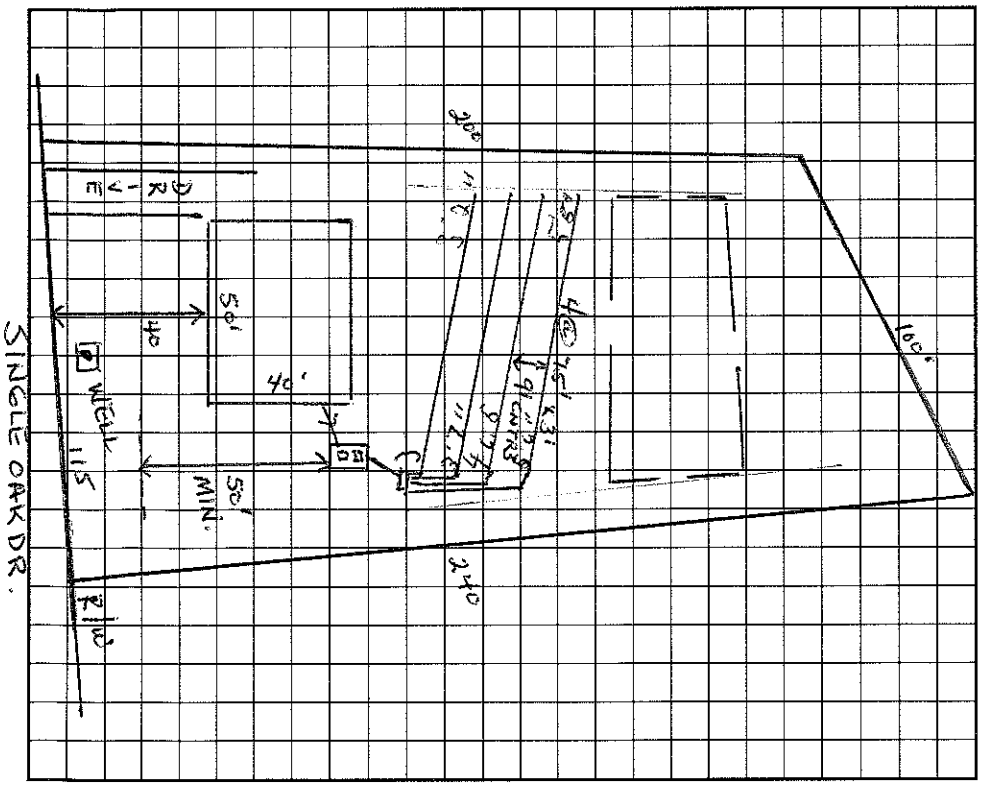

AS BUILT SKETCH

I understand that this permit can be suspended or revoked if any false information is supplied toward securing the permit/any unauthorized changes are made to the site/any unauthorized changes are made in the installation of the system. Improvement Permit is valid for 60 months from date of issuance.

Signed: Paul G. Rupp

Improvement Permit by: Wesley Sparks R.S. date 6/9/95

Existing System Inspection by: _____ date _____

Installed by: Rowan Septic Co.

Certificate of Completion by: Wesley Sparks R.S. date 12/20/95

Operation Permit by: Wesley Sparks R.S. date 12/20/95

HEALTH DEPT. COPY: WHITE INSPECTION COPY (FINAL): GREEN OWNER COPY (FINAL): YELLOW INSPECTION COPY (INITIAL): PINK OWNER COPY (INITIAL): GOLD