IREDELL COUNTY HEALTH DEPARTMENT

STATESVILLE 704-878-5305 MOORESVILLE 704-664-5281

IMPROVEMENT PERMIT / CERTIFICATE OF COMPLETION / OPERATION PERMIT / EXISTING SYSTEM INSPECTION

PROPERTY DESCRIPTION NO. 16991 DATE 9/20/93 TAX MAP NO. 4G-4-A-58

OWNER OR CONTRACTOR MEL GRAHAM INC. PHONE: Business 552-5338 Home

ADDRESS PARK RD CHAR. NC. 4750-99-3243

LOCATION SINGLE OAK DR.

SUBDIVISION PHESANT RUN BLOCK / SECTION III LOT 58 LOT AREA SITE CLASS. P L.T.A.R. [3-35]

Water Supply: ☑ Individual ☐ Community ☐ Public

Septic Tank: 1000 Gallons; STB 925 Date 11.1.93

Pump Tank: Gallons; PT Date

Nitrification Field: No Fields 1 Square Feet 1028 Linear Feet 342

No Lines 5 Trench Width 3' Trench Depth 3' Gravel Depth 12"

☑ New System ☐ Repair System Type: I, (II), II, IV, V, VI

System Description: CONV.

Repair System Description: CONV.

Maintenance Agreement Required: ☐ Yes ☑ No

☑ House/Mod. Home No. Bedrooms 3 Garbage Disposal: ☐ Yes ☑ No

☐ Mobile Home No. Bathrooms 2 Auto. Dishwasher: ☑ Yes ☐ No


☐ Business No. Employees Auto. Washing Machine: ☑ Yes ☐ No

☐ Other Other

☑ Slab ☐ Crawl Space ☐ Basement w/plumbing ☐ Basement wo/plumbing

Comments 1- DITCH SHOULD BE DEEPENED AND CONTINUED BEYOND DRAINFIELD AND REPAIR AREA. TRENCH DEPTH 33-34" AT BOTTOM - CONTOURS TRICKY SO BE CAREFUL

INITIAL SITE SKETCH

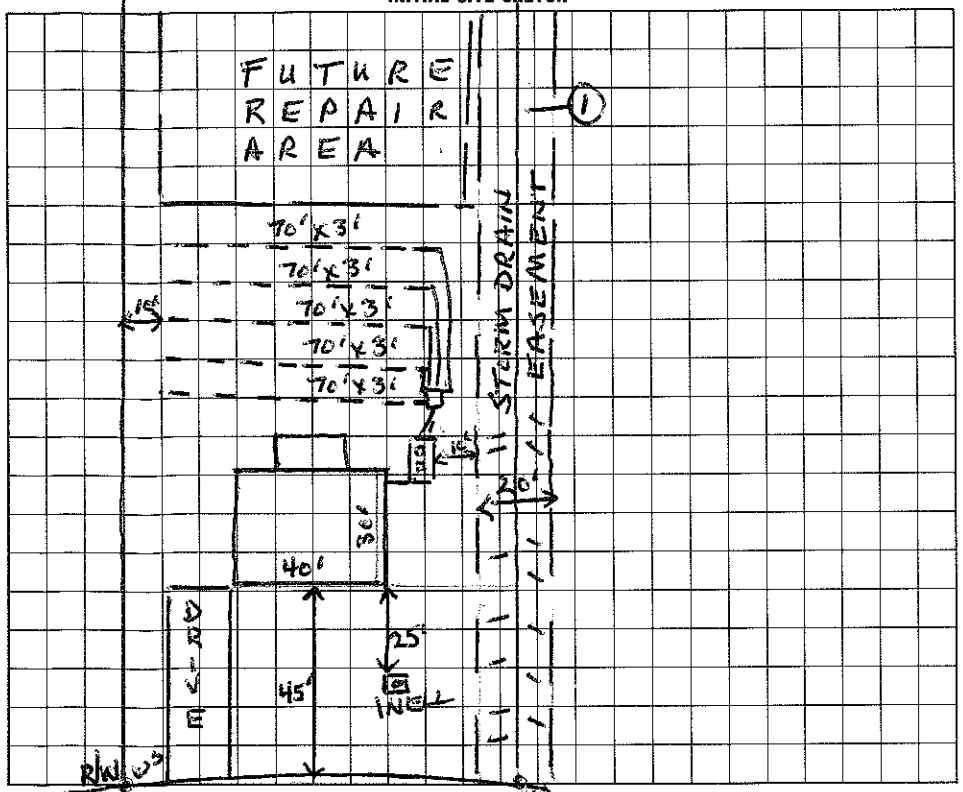

AS BUILT SKETCH

installed as shown.

I understand that this permit can be suspended or revoked if any false information is supplied toward securing the permit/any unauthorized changes are made to the site/any unauthorized changes are made in the installation of the system. Improvement Permit is valid for 60 months from date of issuance.

Signed: CARROL FISHER CONST.

Improvement Permit by: Wesley Sparks R.S. date 9/20/93

Existing System Inspection by: date

Installed by: Rowan Septic Tank

Certificate of Completion by: Wesley Sparks R.S. date 12/17/93

Operation Permit by: date

HEALTH DEPT. COPY: WHITE INSPECTION COPY (FINAL): GREEN OWNER COPY (FINAL): YELLOW INSPECTION COPY (INITIAL): PINK OWNER COPY (INITIAL): GOLD