IREDELL COUNTY HEALTH DEPARTMENT

STATESVILLE 704-878-5305 MOORESVILLE 704-664-5281

IMPROVEMENT PERMIT / CERTIFICATE OF COMPLETION / OPERATION PERMIT / EXISTING SYSTEM INSPECTION

PROPERTY DESCRIPTION NO. ~~4G 4A 59~~ 16590 DATE 1/31/94 TAX MAP NO. ~~16590~~ 4G 4A 59 Watershed: ☐ Yes ☑ ~~No~~

OWNER OR CONTRACTOR CARROL FISHER CONST. CO. PHONE: Business Home

ADDRESS 614 N MAIN ST SALISBURY, NC. 2814 4150-99-4312

LOCATION SINGLE OAK DR., WEATHERS CRK ® OFF OF ~~AIMRO~~ TR TO LOT ON ® AT TOP OF HILL

SUBDIVISION PHESANT RUN BLOCK / SECTION LOT 59 LOT AREA ~ .5AC SITE CLASS. P DESIGN FLOW 360 L.T.A.R. 1.2 - .25

Septic Tank: 1000 Gallons; STB 825 Date 4/24/94

Pump Tank: Gallons; PT Date

Pump Make: Model 1386 Serial No. 462

Nitrification Field: No Fields 1 Square Feet 1440 Linear Feet ~~480~~

No Lines ~~5~~ Trench Width 3 Max Trench Bottom Depth 32" Gravel Depth 12"

☑ New System ☐ Repair System Type: I, ⓘ III, IV, V, VI

System Description: CONV - DROP BOX

Repair System Description: SAME

Maintenance Agreement Required: ☐ Yes ☑ No

☑ House/Mod. Home No. Bedrooms 3

☐ Mobile Home No. Bathrooms 2

☐ Business No. Employees

☐ Other

☐ Slab ☑ Crawl Space ☐ Basement w/plumbing ☐ Basement wo/plumbing


Water Supply: ☑ Individual ☐ Community ☐ Public

Comments:


CONTOUR IMPORTANT! 10' INSIDE ALL PROPERTY LINES.

Comments:

INITIAL SITE SKETCH

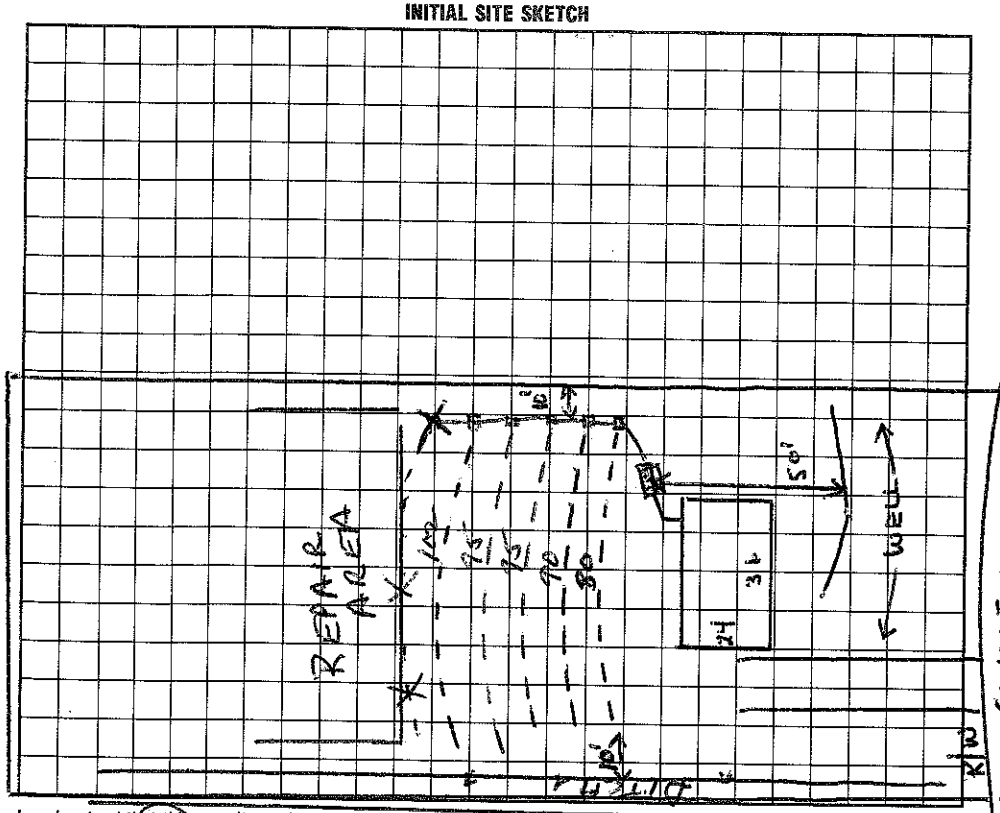

AS BUILT SKETCH

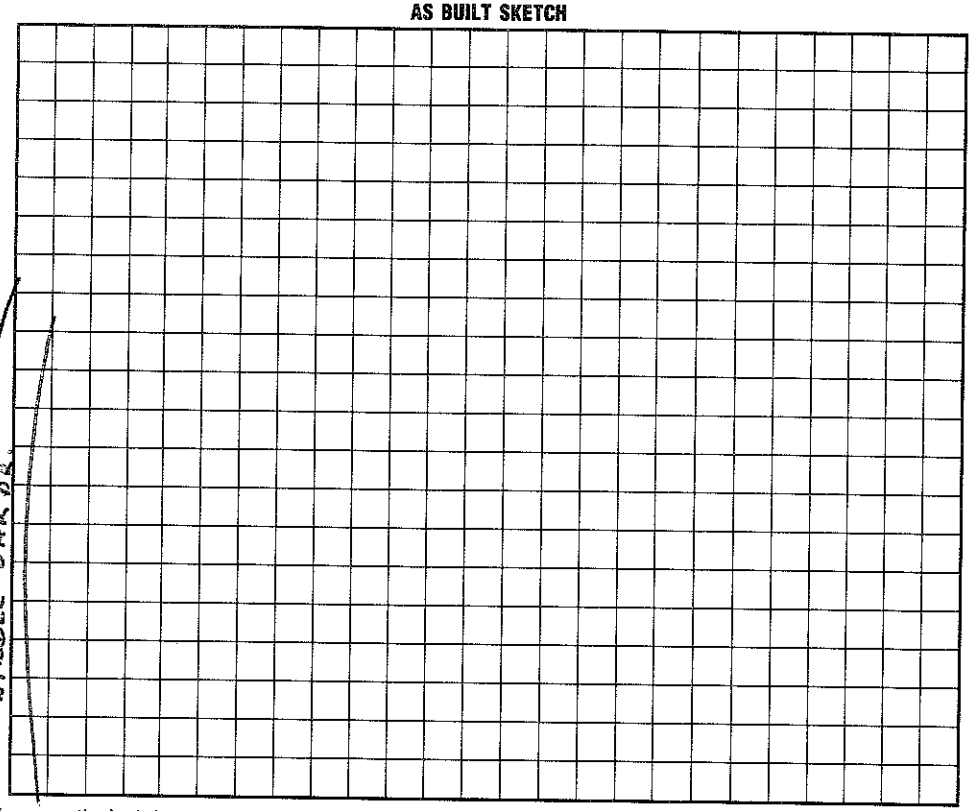

I understand that this permit can be suspended or revoked if any false information is supplied toward securing the permit/any unauthorized changes are made to the site/any unauthorized changes are made in the installation of the system. Improvement Permit is valid for 60 months from date of issuance.

Signed: [signature]

Improvement Permit by: Wesley Sparks RS. date 1/31/94

Existing System Inspection by: date

Installed by: Rowan Septic Tank

Certificate of Completion by: Wesley Sparks RS. date 6/22/94

Operation Permit by: date

HEALTH DEPT. COPY: WHITE INSPECTION COPY (FINAL): GREEN OWNER COPY (FINAL): YELLOW INSPECTION COPY (INITIAL): PINK OWNER COPY (INITIAL): GOLD