IREDELL COUNTY HEALTH DEPARTMENT

STATESVILLE 704-878-5305 #130 MOORESVILLE 704-664-5281

IMPROVEMENT PERMIT / AUTHORIZATION TO CONSTRUCT / OPERATION PERMIT / EXISTING SYSTEM INSPECTION

PERMIT# 115327 PIN# 4750 99 5487 DATE 9/9/03

OWNER OR CONTRACTOR Fleetwood of Trentmen PHONE: Business 704-528-7120 Home

ADDRESS 1040 Charlotte Hwy Trentmen NC. 28166 / 128 Single Oak Dr.

LOCATION 115 N TR Shinnville Rd TL Weathers Creek Rd, TL Single Oak Dr., 7th lot on (R)

SUBDIVISION Pheasant Run BLOCK / SECTION 3 LOT 61 LOT AREA .74AC SITE CLASS. PS DESIGN FLOW 360 L.T.A.R. .3

Septic Tank: 1000 Gallons; STB 1012 Date 3/14/03
Pump Tank: ___ Gallons; PT ___ Date ___
Pump Make: ___ Model ___ Serial No. ___
Nitrification Field: No Fields 1 Square Feet 400/600 Linear Feet 200
No Lines ~~1~~ 5 Trench Width 2-3 Max Trench Bottom Depth 30" Gravel Depth N/A

[X] New System [ ] Repair System Type: I, II, (III) IV, V, VI
System Description: Dist Box to ~~EZ-FLO PS~~ TYPE 3
Repair System Description: Same
Maintenance Agreement Required: [ ] Yes [X] No

[X] House/Mod. Home No. Bedrooms 3
[ ] Mobile Home No. Bathrooms 3
[ ] Business No. Employees ___
[ ] Other ___
[ ] Slab [X] Crawl Space [ ] Basement w/plumbing [ ] Basement wo/plumbing


Water Supply: [X] Individual [ ] Public [ ] Community

Comments:/Conditions: 2' on 8' Centers - 3' on 9' Centers
[3@100'x3']


Comments:/Conditions:

(1" = 50')

INITIAL SITE SKETCH

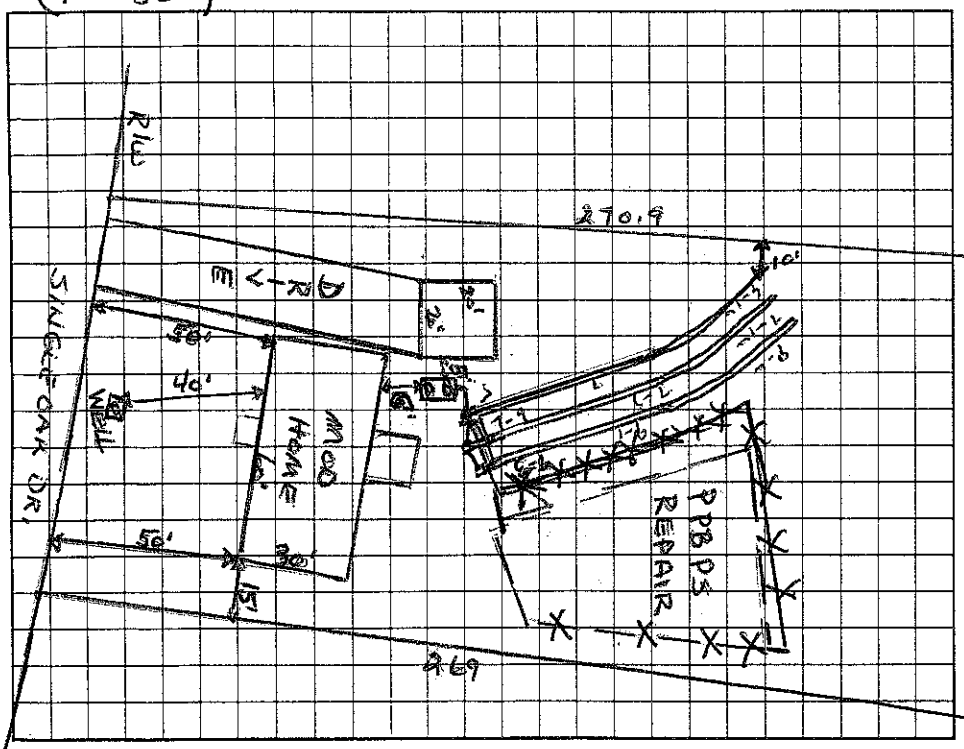

AS BUILT SKETCH

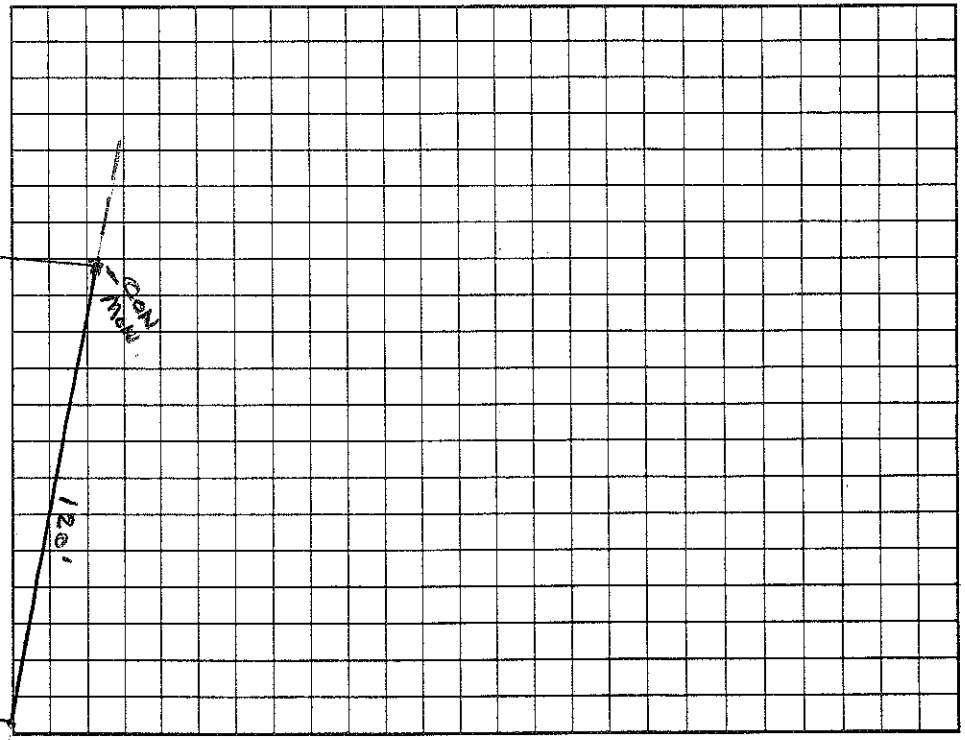

Permit can be suspended or revoked if any false information is supplied toward securing the permit/any unauthorized changes are made to the site/any unauthorized changes are made in the installation of the system. Improvement Permit with plat valid without expiration. Improvement Permit with site plan valid for sixty months. Authorization to Construct is valid for a period equal to that of Improvement Permit – not to exceed sixty months.

Signed: Chris Johnson date 9/9/03 Installed by: Craig Thompson

Improvement Permit by: Wesley Sparks R.S. date 9/9/03 Operation Permit by: Wesley Sparks R.S. date 10/3/03

Authorization to Construct by: Wesley Sparks R.S. date 9/9/03 Existing System Inspection by: ___ date ___

HEALTH DEPT. COPY: WHITE OWNER COPY (FINAL): YELLOW OWNER COPY (INITIAL): PINK