IREDELL COUNTY HEALTH DEPARTMENT

Authorization to Construct

STATESVILLE 704-878-5305 MOORESVILLE 704-664-5281

IMPROVEMENT PERMIT / ~~CERTIFICATE OF COMPLETION~~ / OPERATION PERMIT / EXISTING SYSTEM INSPECTION

PROPERTY DESCRIPTION NO. 22261 DATE 10/3/95 TAX MAP NO. 4G 4A 33 Watershed: ☐ Yes ☒ No

OWNER OR CONTRACTOR Mal Dickson Const. / Carroll Fisher Const. PHONE: Business 704-633-6124 Home 4750-99-6005

ADDRESS 614 N Main St. Salisbury, NC. 28144

LOCATION Pheasant Run - Weathersbee Rd. TL Single Oak to 6th lot on (L)

SUBDIVISION Pheasant Run BLOCK / SECTION 3 LOT 33 LOT AREA .63Ac SITE CLASS PS DESIGN FLOW 360 L.T.A.R. .3

Septic Tank: 1000 Gallons; STB 825 Date 11/17/95

Pump Tank: _____ Gallons; PT _____ Date _____

Pump Make: _____ Model _____ Serial No. _____

Nitrification Field: No Fields 1 Square Feet 1200 Linear Feet 320*

No Lines 8 3 Trench Width 36" Max Trench Bottom Depth 36" Gravel Depth N/A

☒ New System ☐ Repair System Type: I, II, (III) IV, V, VI

System Description: INFILTRATOR

Repair System Description: SAME

Maintenance Agreement Required: ☐ Yes ☒ No

☒ House/Mod. Home No. Bedrooms 3

☐ Mobile Home No. Bathrooms 2

☐ Business No. Employees _____

☐ Other _____


☐ Slab ☒ Crawl Space ☐ Basement w/plumbing ☐ Basement wo/plumbing

Water Supply: ☒ Individual ☐ Community ☐ Public


Comments: * 25% reduction for Infiltrator

Comments:

INITIAL SITE SKETCH

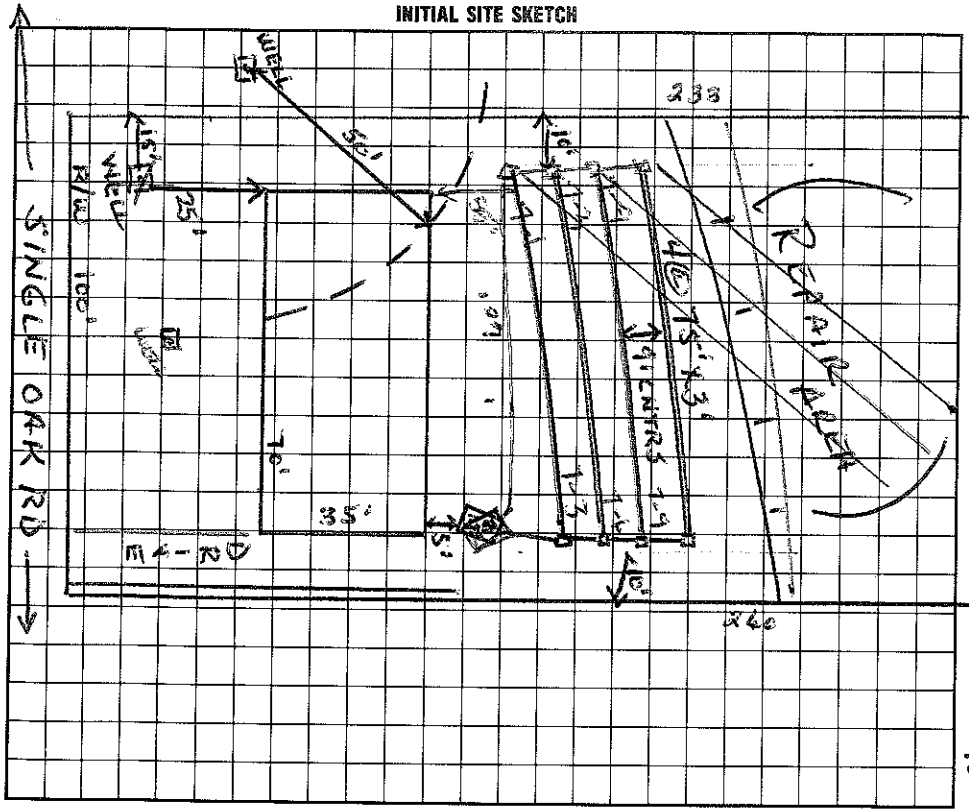

AS BUILT SKETCH

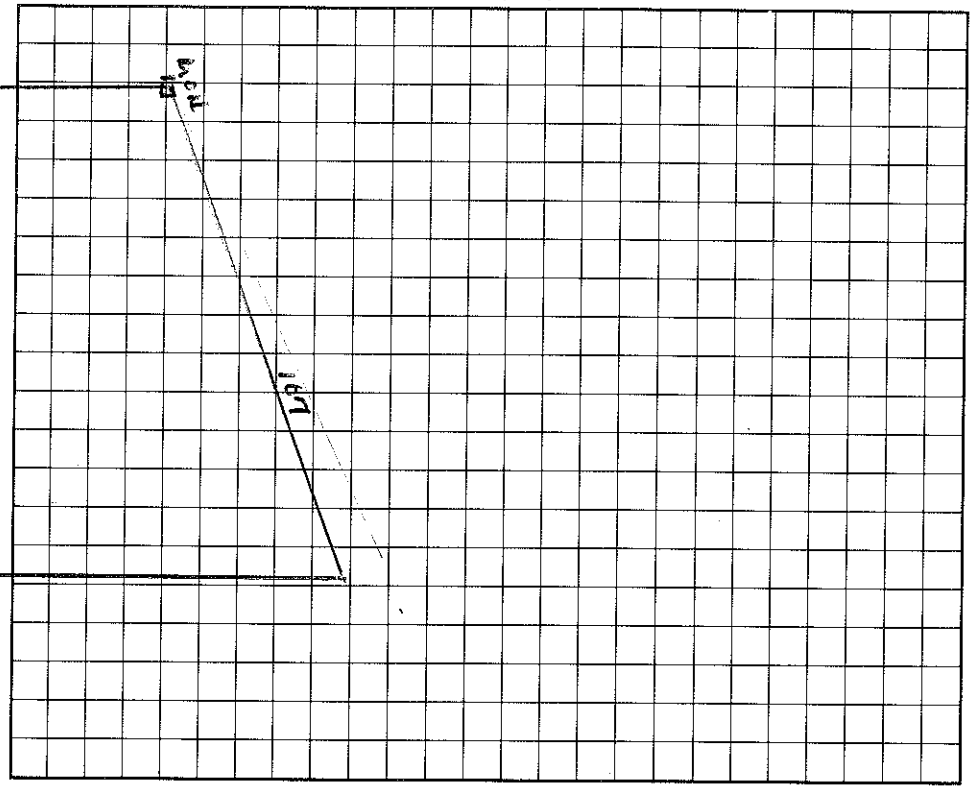

I understand that this permit can be suspended or revoked if any false information is supplied toward securing the permit/any unauthorized changes are made to the site/any unauthorized changes are made in the installation of the system.

AUTHORIZATION TO CONSTRUCT VALID FOR 5 YEARS FROM ISSUE DATE.

Signed: _____

Improvement Permit by: Wesley Sparks RS. date 10/3/95

~~Authorization to Construct~~ Existing System Inspection by: Wesley Sparks RS date 10/3/95

Installed by: Rowan Septic Tank

~~Certificate of Completion~~ by: EM date _____

Operation Permit by: Wesley Sparks RS. date 2/22/96

HEALTH DEPT. COPY: WHITE INSPECTION COPY (FINAL): GREEN OWNER COPY (FINAL): YELLOW INSPECTION COPY (INITIAL): PINK OWNER COPY (INITIAL): GOLD