IREDELL COUNTY HEALTH DEPARTMENT

STATESVILLE 704-878-5305 MOORESVILLE 704-664-5281

IMPROVEMENT PERMIT / CERTIFICATE OF COMPLETION / OPERATION PERMIT / EXISTING SYSTEM INSPECTION

PROPERTY DESCRIPTION NO. 18603 DATE 6/7/94 TAX MAP NO. 4G 4 A 43 Watershed: ☐ Yes ☒ No

OWNER OR CONTRACTOR Carroll Fisher Const. Co PHONE: Business 633-6124 ~~Home~~ 4750-99-6154

ADDRESS 614 N Main St. Salisbury, NC. 28144

LOCATION Sing Oak Dr. (L) off Weatherstone Rd. 4th Lot on (L)

SUBDIVISION Pheasant Run BLOCK / SECTION II LOT 32 LOT AREA .53 AC SITE CLASS. P DESIGN FLOW 360 L.T.A.R. .25-.3

Septic Tank: 1000 Gallons; STB 825 Date 6-7-94

Pump Tank: na Gallons; PT ____ Date ____

Pump Make: na Model ____ Serial No. ____

Nitrification Field: No Fields 1 Square Feet 1200 Linear Feet 400

No Lines 5 Trench Width 3' Max Trench Bottom Depth 36" Gravel Depth 12"

☒ New System ☐ Repair System Type: I, (II), III, IV, V, VI

System Description: DROP BOX - CONVENTIONAL

Repair System Description: ____

Maintenance Agreement Required: ☐ Yes ☒ No

☒ House/Mod. Home ☐ Mobile Home ☐ Business ☐ Other ____


No. Bedrooms 3 No. Bathrooms 2 No. Employees ____

☒ Slab ☐ Crawl Space ☐ Basement w/plumbing ☐ Basement wo/plumbing

Water Supply: ☒ Individual ☐ Community ☐ Public


Comments: WS WS

INITIAL SITE SKETCH

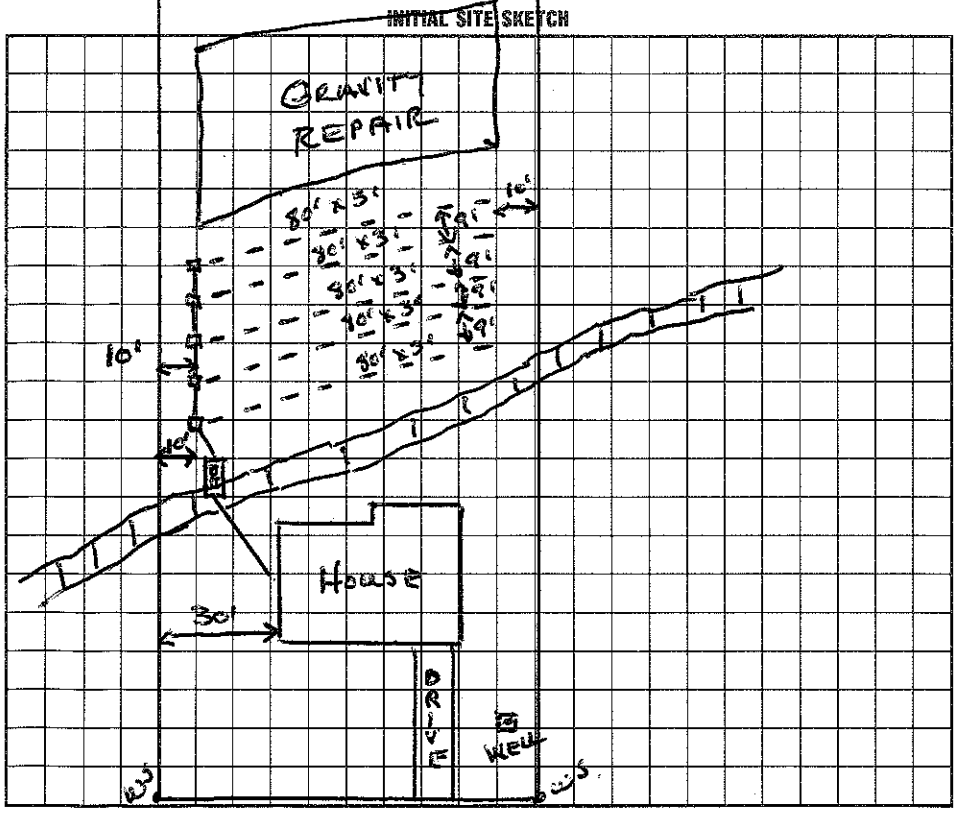

Comments: Re-seal baffle → O.K. two drop boxes sealed

AS BUILT SKETCH

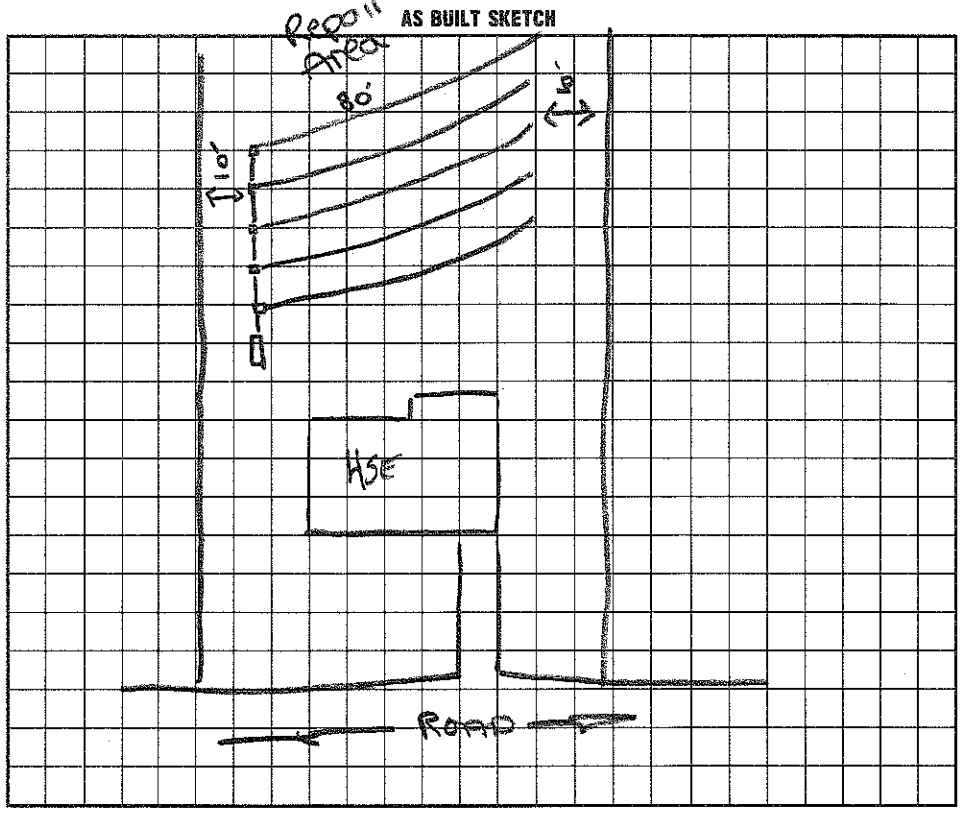

I understand that this permit can be suspended or revoked if any false information is supplied toward securing the permit/any unauthorized changes are made to the site/any unauthorized changes are made in the installation of the system. Improvement Permit is valid for 60 months from date of issuance.

Signed: [signature]

Improvement Permit by: Wesley Parker R.S. date 6/7/94

Existing System Inspection by: ____ date ____

Installed by: Rowan Septic Tank

Certificate of Completion by: Andrea Lemon date 9-15-94

Operation Permit by: ____ date ____

HEALTH DEPT. COPY: WHITE INSPECTION COPY (FINAL): GREEN OWNER COPY (FINAL): YELLOW INSPECTION COPY (INITIAL): PINK OWNER COPY (INITIAL): GOLD