IREDELL COUNTY HEALTH DEPARTMENT
Authorization to Construct STATESVILLE 704-878-5305 MOORESVILLE 704-664-5281

IMPROVEMENT PERMIT / ~~CERTIFICATE OF COMPLETION~~ / OPERATION PERMIT / EXISTING SYSTEM INSPECTION

PROPERTY DESCRIPTION NO. 067818 DATE 7/14/97 TAX MAP NO. 4750997241 Watershed: ☐ Yes ☒ No

OWNER OR CONTRACTOR Mel Graham PHONE: Business JACOBS/663-6905 Home

ADDRESS 6100 Fairview Rd, Suite 810 Char. NC. 28210

LOCATION Shinnville Rd. TL Weathers Creek Rd. TL Single Oak Dr. to 4th lot on (L)

SUBDIVISION Pleasant Run BLOCK / SECTION III LOT 31 LOT AREA .69 SITE CLASS. PS DESIGN FLOW 360 L.T.A.R. .3

Septic Tank: 1000 Gallons; STB Date
Pump Tank: 1000 Gallons; PT Date
Pump Make: Model Serial No.
Nitrification Field: No Fields 1 Square Feet 900* Linear Feet 300*
No Lines 3 Trench Width 36" Max Trench Bottom Depth 30" Gravel Depth SAND

☒ New System ☐ Repair System Type: I, II, (III), IV, V, VI
System Description: PRES MAN → CH PLASTIC
Repair System Description: PRES, 16" PPBS
Maintenance Agreement Required: ☐ Yes ☒ No


☒ House/Mod. Home No. Bedrooms 3
☐ Mobile Home No. Bathrooms 2
☐ Business No. Employees
☐ Other
☐ Slab ☒ Crawl Space ☐ Basement w/plumbing ☐ Basement wo/plumbing

Water Supply:
☒ Individual
☐ Community
☐ Public

Comments: House located in only position to get a acceptable Well on this lot.

Comments:

INITIAL SITE SKETCH

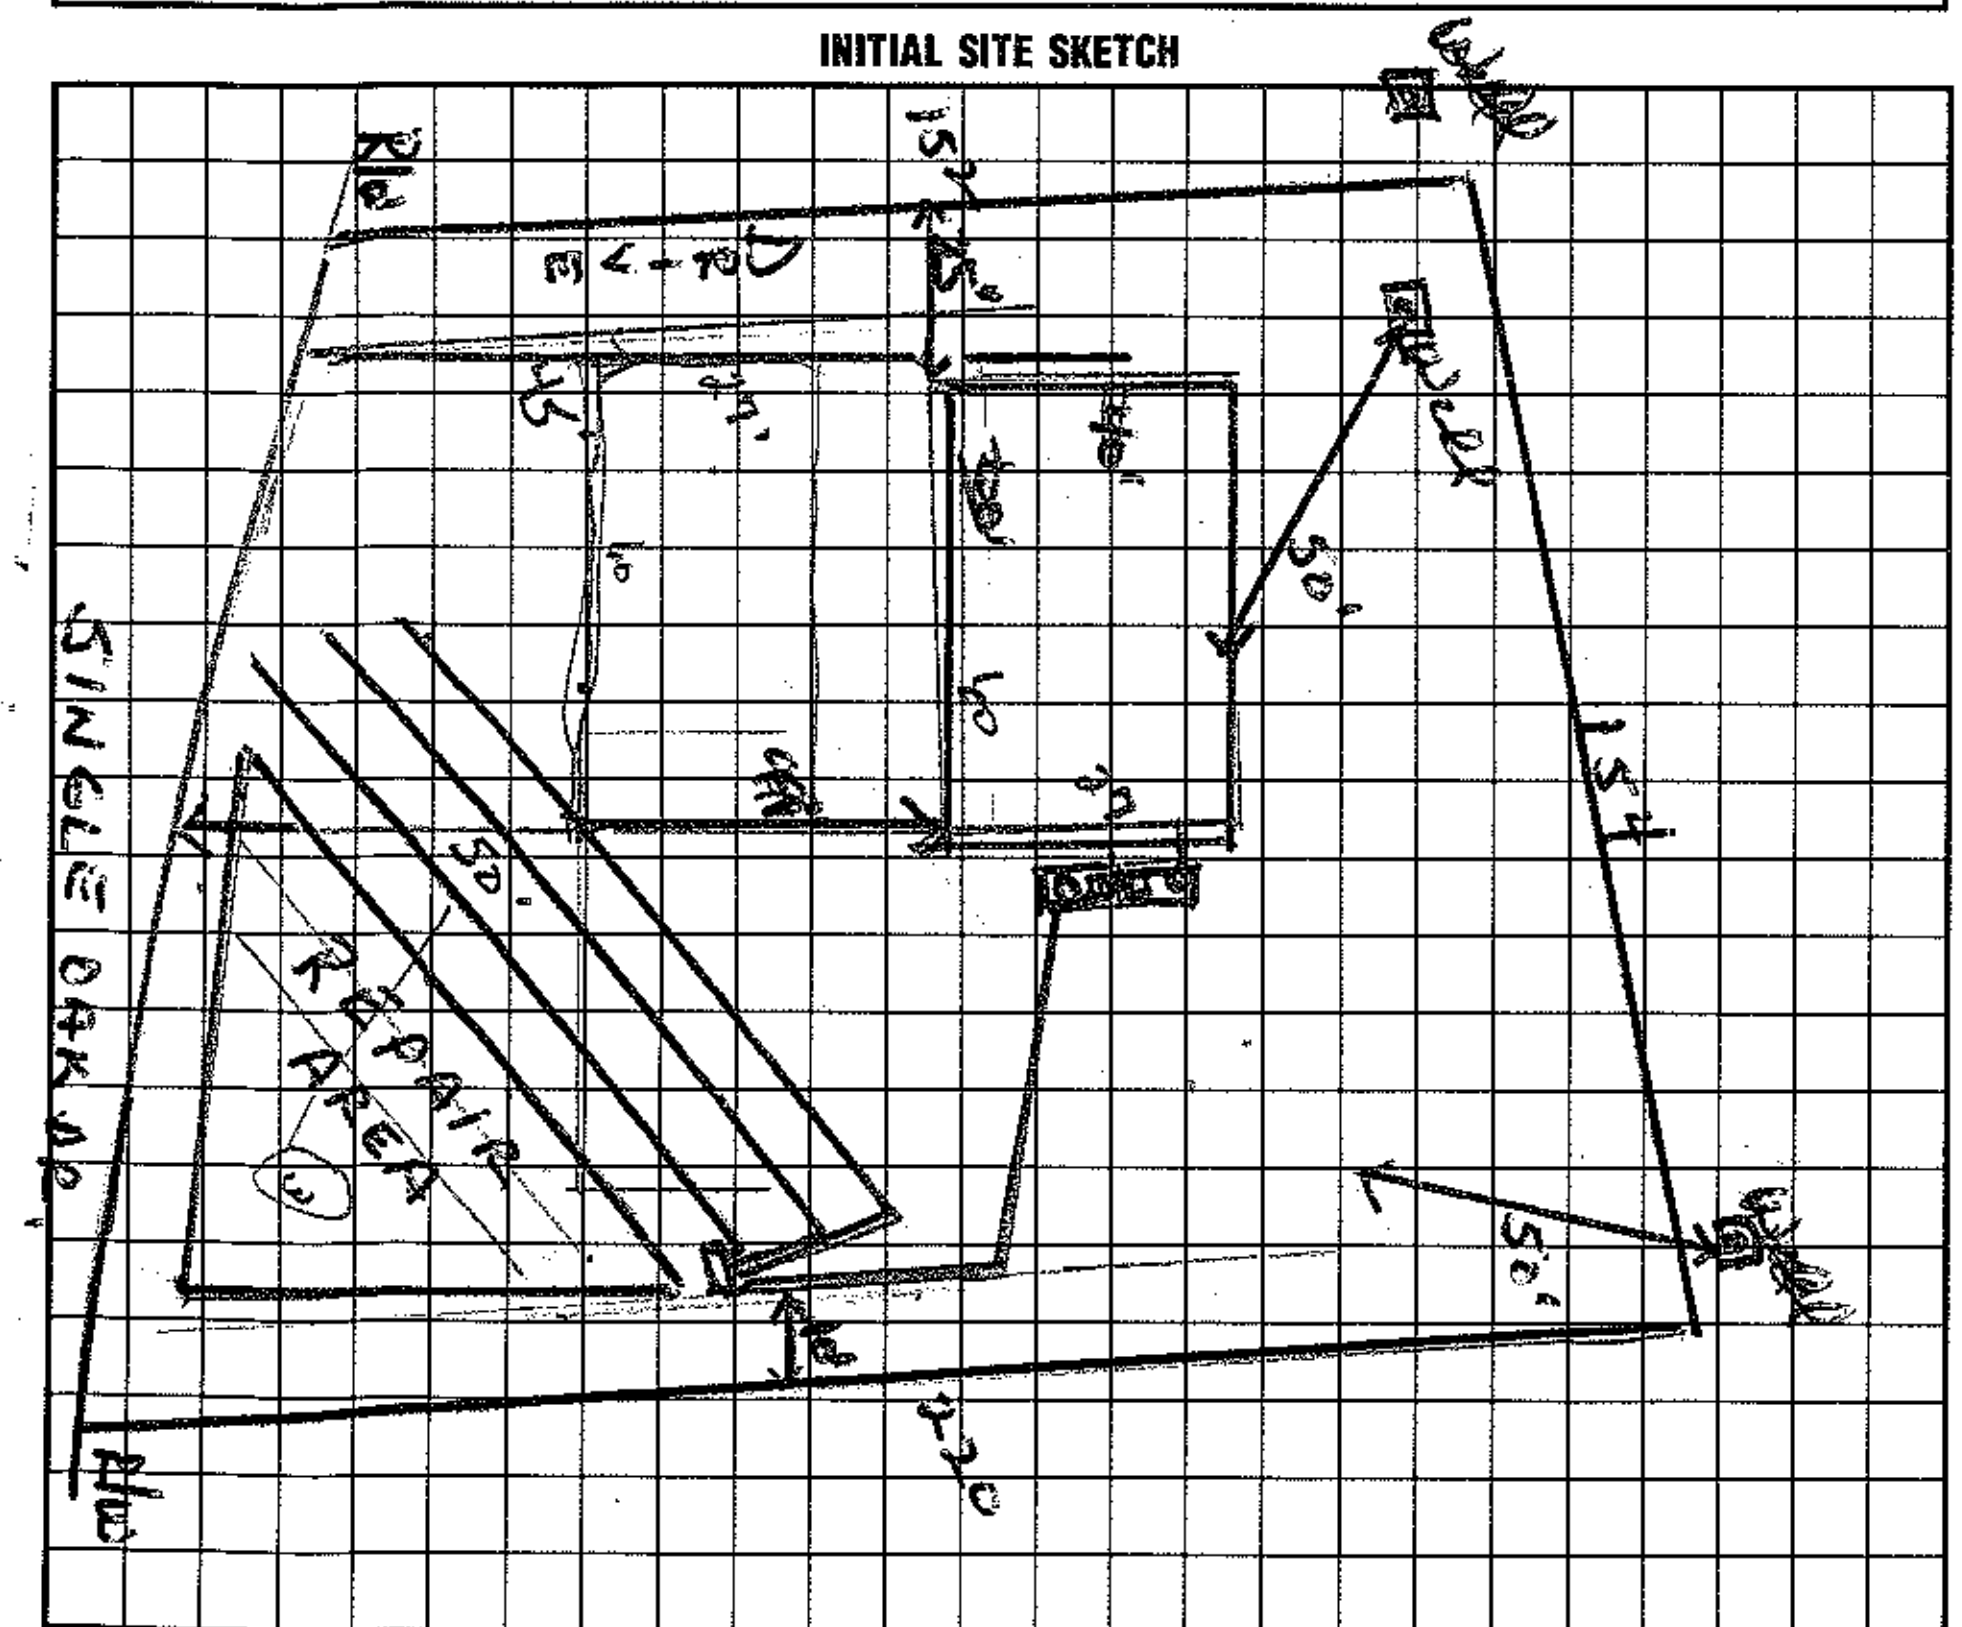

AS BUILT SKETCH

I understand that this permit can be suspended or revoked if any false information is supplied toward securing the permit/any unauthorized changes are made to the site/any unauthorized changes are made in the installation of the system. Improvement Permit is valid for 60 months from date of issuance.

Signed: * Terry Clayton CPSS Agent 7/24/97

Improvement Permit by: Wesley Sparks R.S. date 7/14/97

Existing System Inspection by: Wesley Sparks R.S. date 7/14/97 *Auth to Construct*

Installed by:

Certificate of Completion by: date

Operation Permit by: date

HEALTH DEPT. COPY: WHITE INSPECTION COPY (FINAL): GREEN OWNER COPY (FINAL): YELLOW INSPECTION COPY (INITIAL): PINK OWNER COPY (INITIAL): GOLD