IREDELL COUNTY HEALTH DEPARTMENT

Paid 50.00

STATESVILLE 704-878-5305 MOORESVILLE 704-664-5281

IMPROVEMENT PERMIT / AUTHORIZATION TO CONSTRUCT / OPERATION PERMIT / EXISTING SYSTEM INSPECTION

PERMIT# 067818 PIN# 4750 99 7241 DATE 8/29/00

OWNER OR CONTRACTOR Leader Homes PHONE: Business 662-8436 Home

ADDRESS Plaza Dr. Mooresville, NC. 28115

LOCATION Shumsville Rd. TL Weathers Creek Rd TL Single Oak Dr. to 4th lot on (L)

SUBDIVISION Pleasant Run BLOCK / SECTION III LOT 31 LOT AREA .67 SITE CLASS RS DESIGN FLOW 360 L.T.A.R. .3

Septic Tank: 1000 Gallons; STB 1012 Date 6/12/00
Pump Tank: Gallons; PT Date
Pump Make: Model Serial No.
Nitrification Field: No Fields 1 Square Feet 900± Linear Feet 300±
No Lines 4@75' Trench Width Max Trench Bottom Depth Gravel Depth


☑ New System ☐ Repair System Type: I, II, III, IV, V, VI
System Description: TYPE 3
Repair System Description:
Maintenance Agreement Required: ☐ Yes ☐ No

☐ House/Mod. Home No. Bedrooms 3
☐ Mobile Home No. Bathrooms 2
☐ Business No. Employees
☐ Other
☐ Slab ☐ Crawl Space ☐ Basement w/plumbing ☐ Basement wo/plumbing

Water Supply:
☐ Individual
☐ Public
☐ Community

Comments:/Conditions:

INITIAL SITE SKETCH

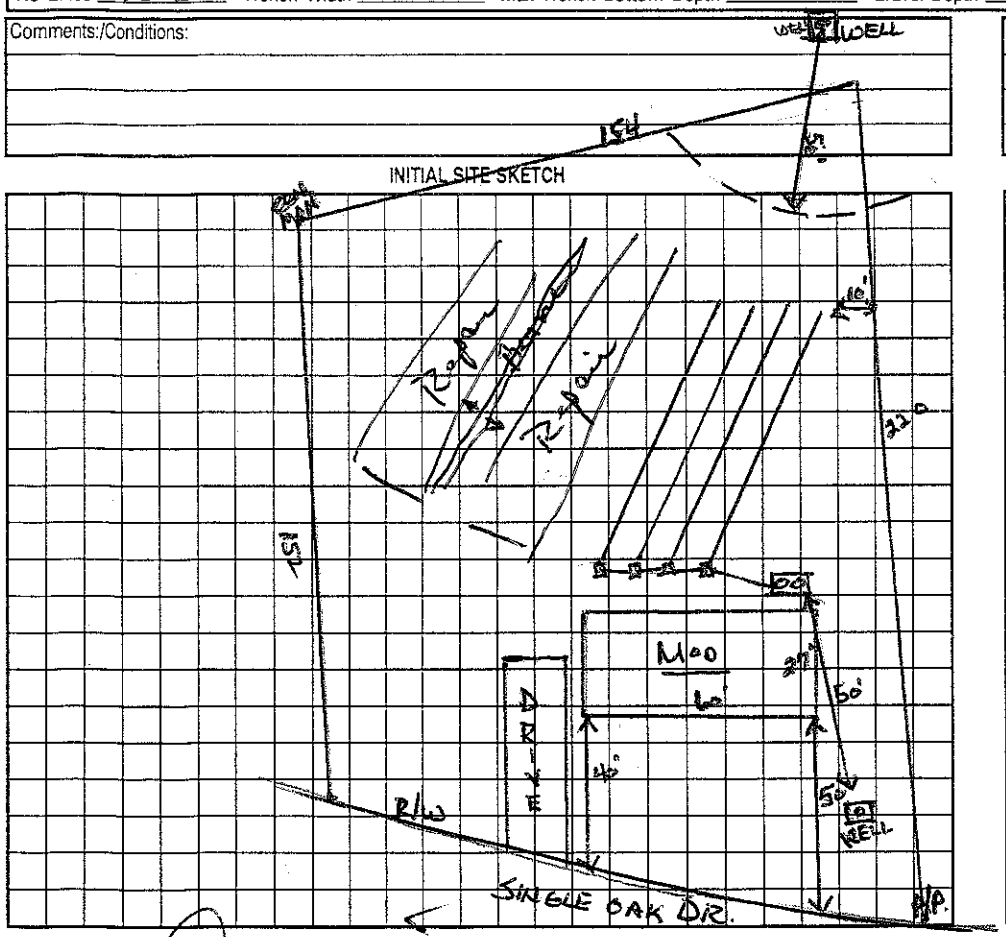

Comments:/Conditions: 8/31/00 well not in - installed as shown

AS BUILT SKETCH

Permit can be suspended or revoked if any false information is supplied toward securing the permit/any unauthorized changes are made to the site/any unauthorized changes are made in the installation of the system. Improvement Permit with plat valid without expiration. Improvement Permit with site plan valid for sixty months. Authorization to Construct is valid for a period equal to that of Improvement Permit – not to exceed sixty months.

Signed: Paul Arnold date 8-31-00 Installed by: A-1 Backhoe

Improvement Permit by: Wesley Sparks RS. date 8/29/00 Operation Permit by: Wesley Sparks RS. date 8/31/00

Authorization to Construct by: Wesley Sparks RS. date 8/29/00 Existing System Inspection by: date

HEALTH DEPT. COPY: WHITE OWNER COPY (FINAL): YELLOW OWNER COPY (INITIAL): PINK