IREDELL COUNTY HEALTH DEPARTMENT

STATESVILLE 704-878-5305 MOORESVILLE 704-664-5281

IMPROVEMENT PERMIT / AUTHORIZATION TO CONSTRUCT / OPERATION PERMIT / EXISTING SYSTEM INSPECTION

PERMIT# 21983 PIN# 4750 99 8383 DATE 10/23/00

OWNER OR CONTRACTOR Bill Phillips PHONE: Business Home 933-0782

ADDRESS 7786 Freeze Rd. Kannapolis, NC. 28081

LOCATION Weathers Creek TL Single Oak Dr. to 3RD lot on (L)

SUBDIVISION Pleasant Run BLOCK / SECTION 3 LOT 30 LOT AREA ~1.2 AC SITE CLASS. PS DESIGN FLOW 360 L.T.A.R. .3

Septic Tank: 1000 Gallons; STB 828 Date 6/19/00
Pump Tank: Gallons; PT Date
Pump Make: Model Serial No.
Nitrification Field: No Fields 1 Square Feet 1200 Linear Feet 360
No Lines 4@75' Trench Width 3' Max Trench Bottom Depth 3'

[X] New System [ ] Repair System Type: I, II, (III), IV, V, VI
System Description: GRAV - EZ FLOW OR CH. PLASTIC
Repair System Description: 16" PPBS
Maintenance Agreement Required: [ ] Yes [X] No
~~Gravel Depth~~ SAND.

[X] House/Mod. Home No. Bedrooms 3
[ ] Mobile Home No. Bathrooms 3
[ ] Business No. Employees
[ ] Other
[ ] Slab [X] Crawl Space [ ] Basement w/plumbing [ ] Basement wo/plumbing


Water Supply:
[X] Individual
[ ] Public
[ ] Community

Comments:/Conditions:

Comments:/Conditions:

(1" = 50')

INITIAL SITE SKETCH

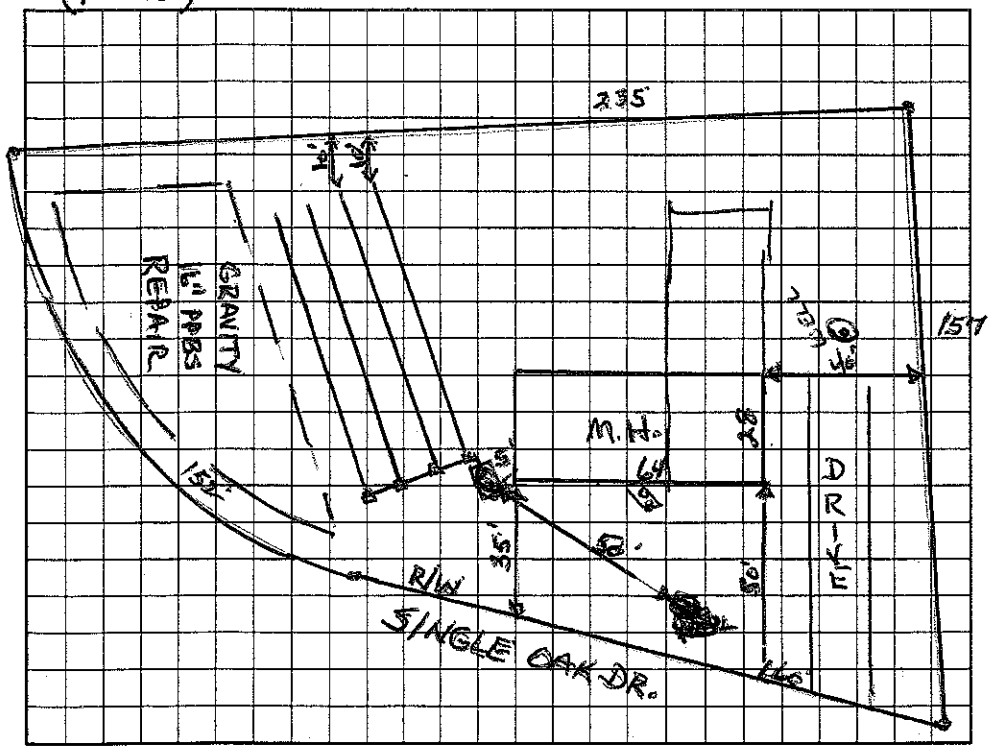

AS BUILT SKETCH

Permit can be suspended or revoked if any false information is supplied toward securing the permit/any unauthorized changes are made to the site/any unauthorized changes are made in the installation of the system. Improvement Permit with plat valid without expiration. Improvement Permit with site plan valid for sixty months. Authorization to Construct is valid for a period equal to that of Improvement Permit – not to exceed sixty months.

Signed: Kathy Boggs date 10-24-00 Installed by: Upright Septic Tank + Grading

Improvement Permit by: Wesley Sparks RS. date 10/23/00 Operation Permit by: Wesley Sparks RS date 2/2/01

Authorization to Construct by: Wesley Sparks RS. date 10/23/00 Existing System Inspection by: date

HEALTH DEPT. COPY: WHITE OWNER COPY (FINAL): YELLOW OWNER COPY (INITIAL): PINK