IREDELL COUNTY HEALTH DEPARTMENT

STATESVILLE 704-878-5305 MOORESVILLE 704-664-5281

IMPROVEMENT PERMIT / CERTIFICATE OF COMPLETION / OPERATION PERMIT / EXISTING SYSTEM INSPECTION

PROPERTY DESCRIPTION NO. 16995 DATE 10/15/93 TAX MAP NO. 46-4-A-29

OWNER OR CONTRACTOR CARROLL FISHER CONST. PHONE: Business 633-6124 ~~Home~~ 4750-99-9275

ADDRESS N. MAIN ST. SALISBURY NC.

LOCATION WEATHERS CRK. 2ND (L) ON LINEOAK TR 2ND LOT ON (L)

SUBDIVISION PHESANT RUN BLOCK / SECTION II LOT 29 LOT AREA .56 SITE CLASS. P. L.T.A.R. .25-.3

Water Supply: ☑ Individual ☐ Community ☐ Public

Septic Tank: 1000 Gallons; STB 825 Date 12/1/93

Pump Tank: _____ Gallons; PT _____ Date _____

Nitrification Field: No Fields 1 Square Feet 1800 Linear Feet 400

No Lines 56 Trench Width 3' Trench Depth 3' Gravel Depth 12"

☑ New System ☐ Repair System Type: I (II), II, IV, V, VI

System Description: DROP BOX - CONV.

Repair System Description: CONV.

Maintenance Agreement Required: ☐ Yes ☑ No

☑ House/Mod. Home No. Bedrooms 3 Garbage Disposal: ☐ Yes ☑ No

☐ Mobile Home No. Bathrooms 2 Auto. Dishwasher: ☑ Yes ☐ No


☐ Business No. Employees _____ Auto. Washing Machine: ☑ Yes ☐ No

☐ Other _____ Other _____


☐ Slab ☑ Crawl Space ☐ Basement w/plumbing ☐ Basement wo/plumbing

Comments KEEP TRENCHES ON SLOPE CONTOUR. DRIVEWAY NEEDS TO BE TIGHT ON (R) SIDE PROPERTY LINE AS SHOWN HERE

INITIAL SITE SKETCH

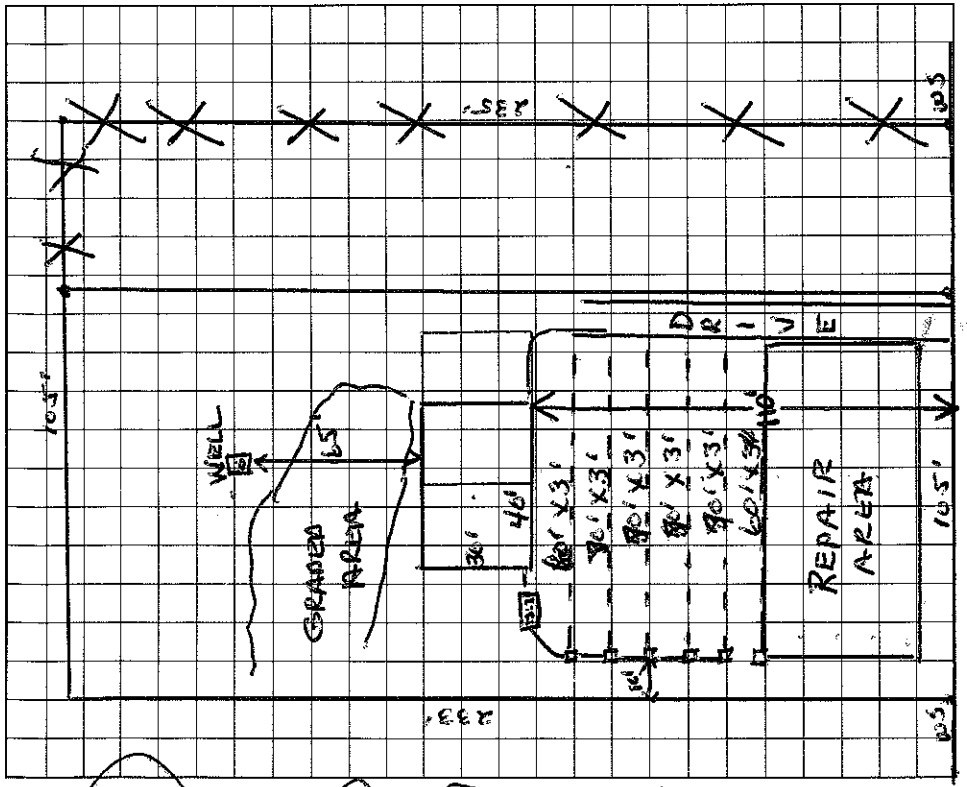

AS BUILT SKETCH

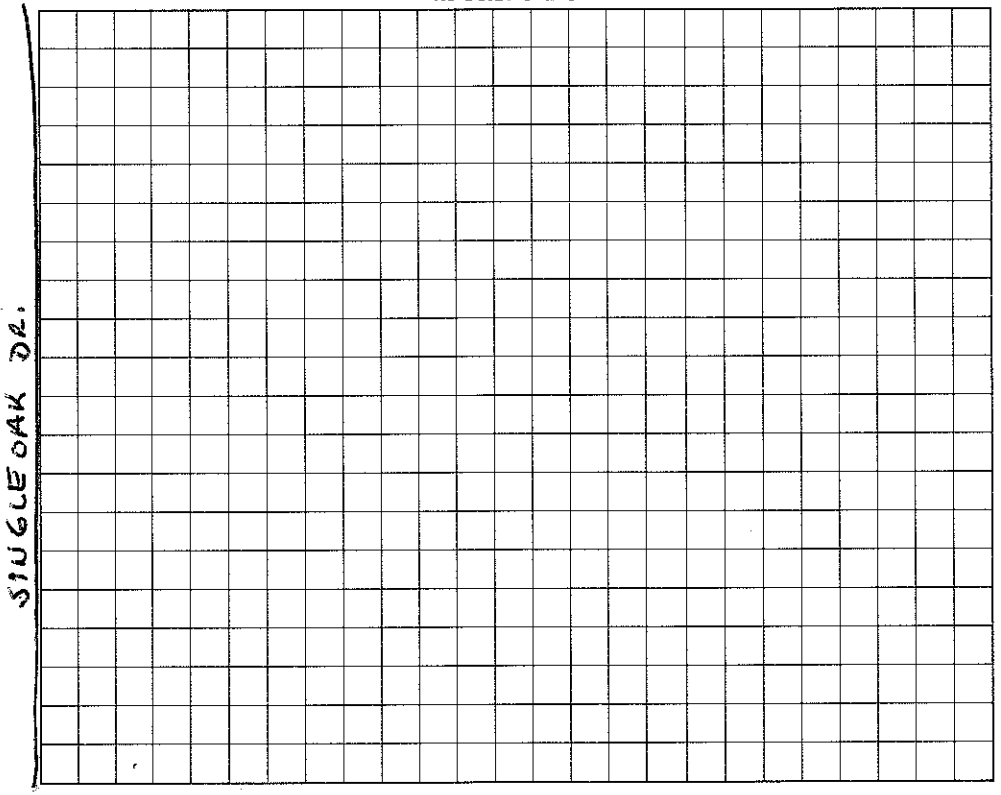

I understand that this permit can be suspended or revoked if any false information is supplied toward securing the permit/any unauthorized changes are made to the site/any unauthorized changes are made in the installation of the system. Improvement Permit is valid for 60 months from date of issuance.

Signed: _____

Improvement Permit by: Wesley Sparks RS. date 10/15/93

Existing System Inspection by: _____ date _____

Installed by: Rowan Septic Tanks

Certificate of Completion by: Wesley Sparks RS date 2/1/94

Operation Permit by: _____ date _____

HEALTH DEPT. COPY: WHITE INSPECTION COPY (FINAL): GREEN OWNER COPY (FINAL): YELLOW INSPECTION COPY (INITIAL): PINK OWNER COPY (INITIAL): GOLD