IREDELL COUNTY HEALTH DEPARTMENT

STATESVILLE 704-878-5305 MOORESVILLE 704-664-5281

GARY HAMMEL - 660-7317 4750-99 9605

IMPROVEMENT PERMIT / AUTHORIZATION TO CONSTRUCT / OPERATION PERMIT / EXISTING SYSTEM INSPECTION

PERMIT# 20274 PIN# 4644 64 DATE 4/7/98

OWNER OR CONTRACTOR Mel Graham (Pheasant Run) PHONE: Business 309-1486 Home 309-1487

ADDRESS

LOCATION Weathers Oak Rd. TL Single Oak Dr. to 4th lot on (R)

SUBDIVISION Pheasant Run BLOCK / SECTION III LOT 64 LOT AREA ~1.14 Ac SITE CLASS PS DESIGN FLOW 240 L.T.A.R. .3

Septic Tank: 1000 Gallons; STB 794 Date 12/11/97

Pump Tank: 1080 Gallons; PT 27 Date 2/13/98

Pump Make: HYDROMATIC Model SK 50 A1 Serial No. 2/98

Nitrification Field: No Fields 1 Square Feet 806 Linear Feet 266

No Lines 3 Trench Width 36" Max Trench Bottom Depth 36" Gravel Depth SAND.

[X] New System [ ] Repair System Type: I, II, III, (IV), V, VI

System Description: Pressure Panel

Repair System Description:

Maintenance Agreement Required: [X] Yes [ ] No

[X] House/Mod. Home [ ] Mobile Home [ ] Business [ ] Other

No. Bedrooms 2 No. Bathrooms 2 No. Employees


[ ] Slab [X] Crawl Space [ ] Basement w/plumbing [ ] Basement wo/plumbing

Water Supply: [X] Individual [ ] Public [ ] Community


Comments:/Conditions: .5 Reduction for use of PPBS 16"

Comments:/Conditions:

INITIAL SITE SKETCH

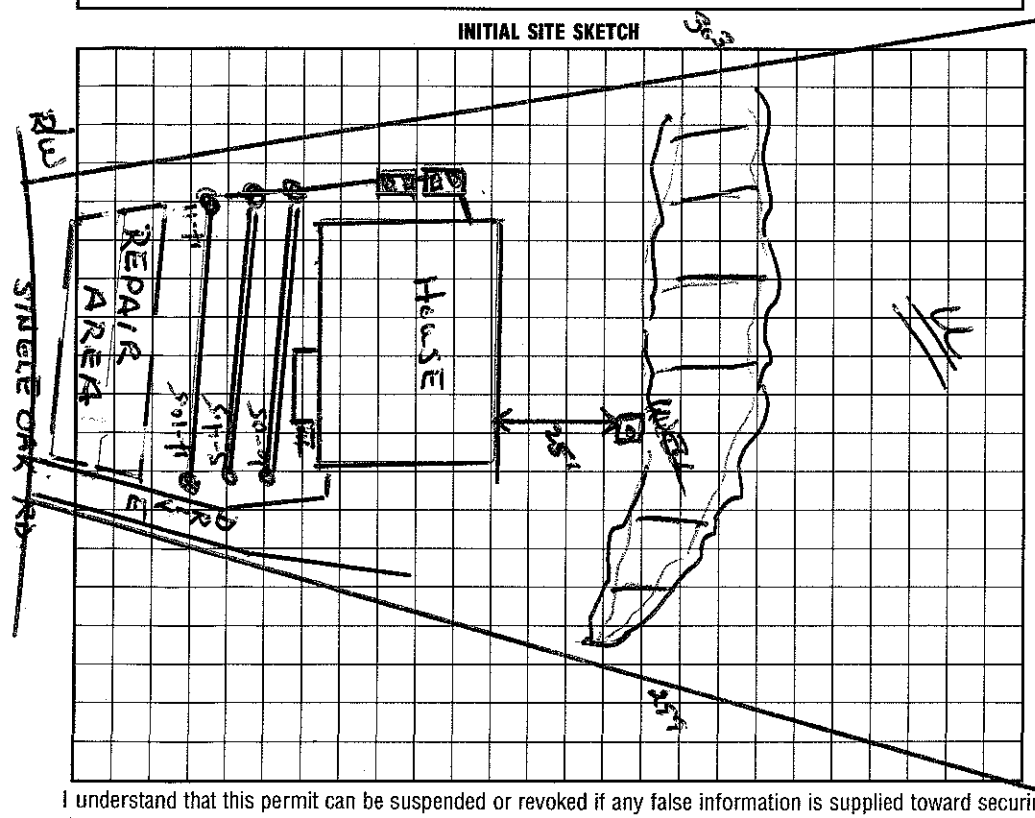

AS BUILT SKETCH

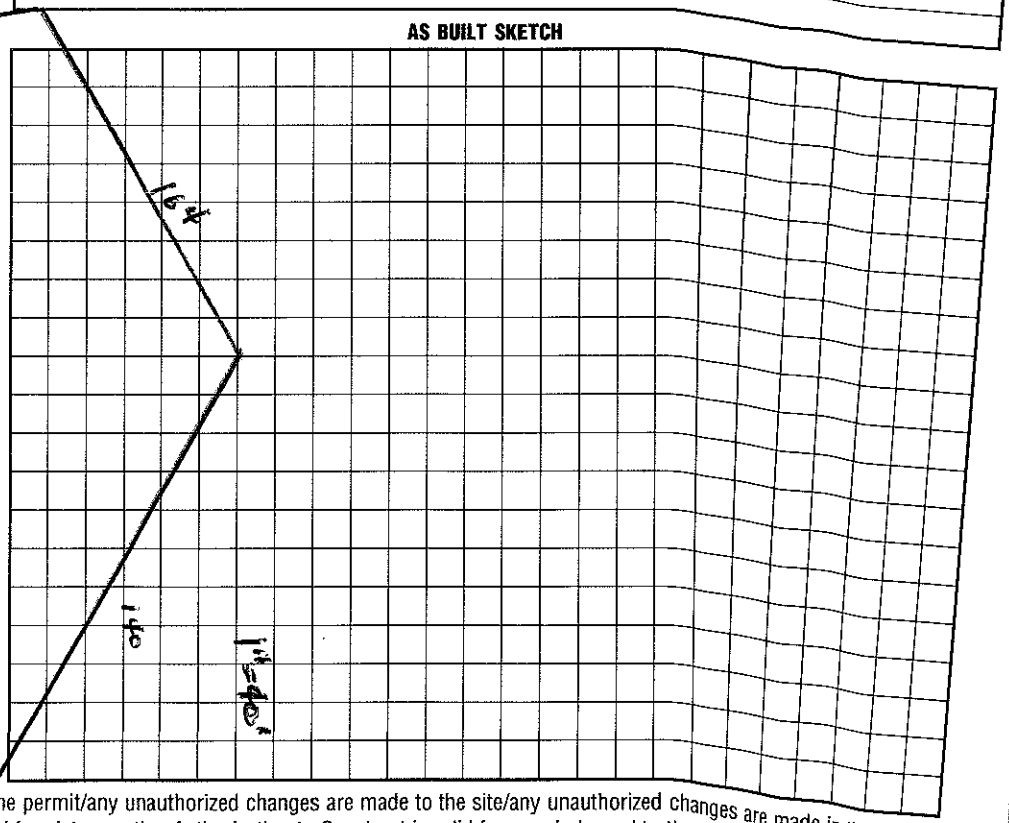

I understand that this permit can be suspended or revoked if any false information is supplied toward securing the permit/any unauthorized changes are made to the site/any unauthorized changes are made in the installation of the system. Improvement Permit with plat valid without expiration. Improvement Permit with site plan valid for sixty months. Authorization to Construct is valid for a period equal to that of Improvement Permit – not to exceed sixty months.

Signed: [signature] date

Improvement Permit by: Wesley Sparks RS. date 4/7/98

Authorization to Construct by: Wesley Sparks RS. date 4/7/98

Installed by: Lavon Benton

Operation Permit by: Wesley Sparks RS date 6/2/98

Existing System Inspection by: date

HEALTH DEPT. COPY: WHITE INSPECTION COPY (FINAL): GREEN OWNER COPY (FINAL): YELLOW INSPECTION COPY (INITIAL): PINK OWNER COPY (INITIAL): GOLD