4751000890 25.00 Paid

IREDELL COUNTY HEALTH DEPARTMENT

STATESVILLE 704-878-5305 MOORESVILLE 704-664-5281

IMPROVEMENT PERMIT / AUTHORIZATION TO CONSTRUCT / OPERATION PERMIT / EXISTING SYSTEM INSPECTI[ON]

PERMIT# 104577 PIN# 4751000748

OWNER OR CONTRACTOR Ronald or Gary Christie (Oakwood Homes) PHONE Billy Business (704) 528-4516 Home DATE 2-21-2002

ADDRESS 6565 Weldon Circle Concord, NC 28025

LOCATION Hwy 115/21 TR Oswalt- Amity Rd on right just past I-77 bridge

SUBDIVISION LH Christie Est. BLOCK / SECTION Tract LOT 4 LOT AREA 7.26 Acres SITE CLASS. PS DESIGN FLOW 480 gpd L.T.A.R. .3

Septic Tank: 1000 Gallons; STB 794 Date 11-18-01

Pump Tank: Gallons; PT Date

Pump Make: Model Serial No.

Nitrification Field: No Fields 1 Square Feet 1599 Linear Feet 533'

No Lines X 8 Trench Width 36" Max Trench Bottom Depth 36" Gravel Depth 12"

[X] New System ☐ Repair System Type: (II) III, IV, V, VI

System Description: Gravity Conventional

Repair System Description: Same

Maintenance Agreement Required: ☐ Yes [X] No

☐ Slab [X] Crawl Space ☐ Basement w/plumbing ☐ Basement wo/plumbing

☐ House/Mod. Home [X] Mobile Home ☐ Business ☐ Other


No. Bedrooms 4 No. Bathrooms 3 No. Employees

Water Supply: [X] Individual ☐ Public ☐ Community

Comments:/Conditions: Scale = 1:100

Comments:/Conditions: Keep Septic System at least 10' from PL & 10' from house. Keep well 100' from Septic system and at least 25' Grey filter installed to house.

INITIAL SITE SKETCH

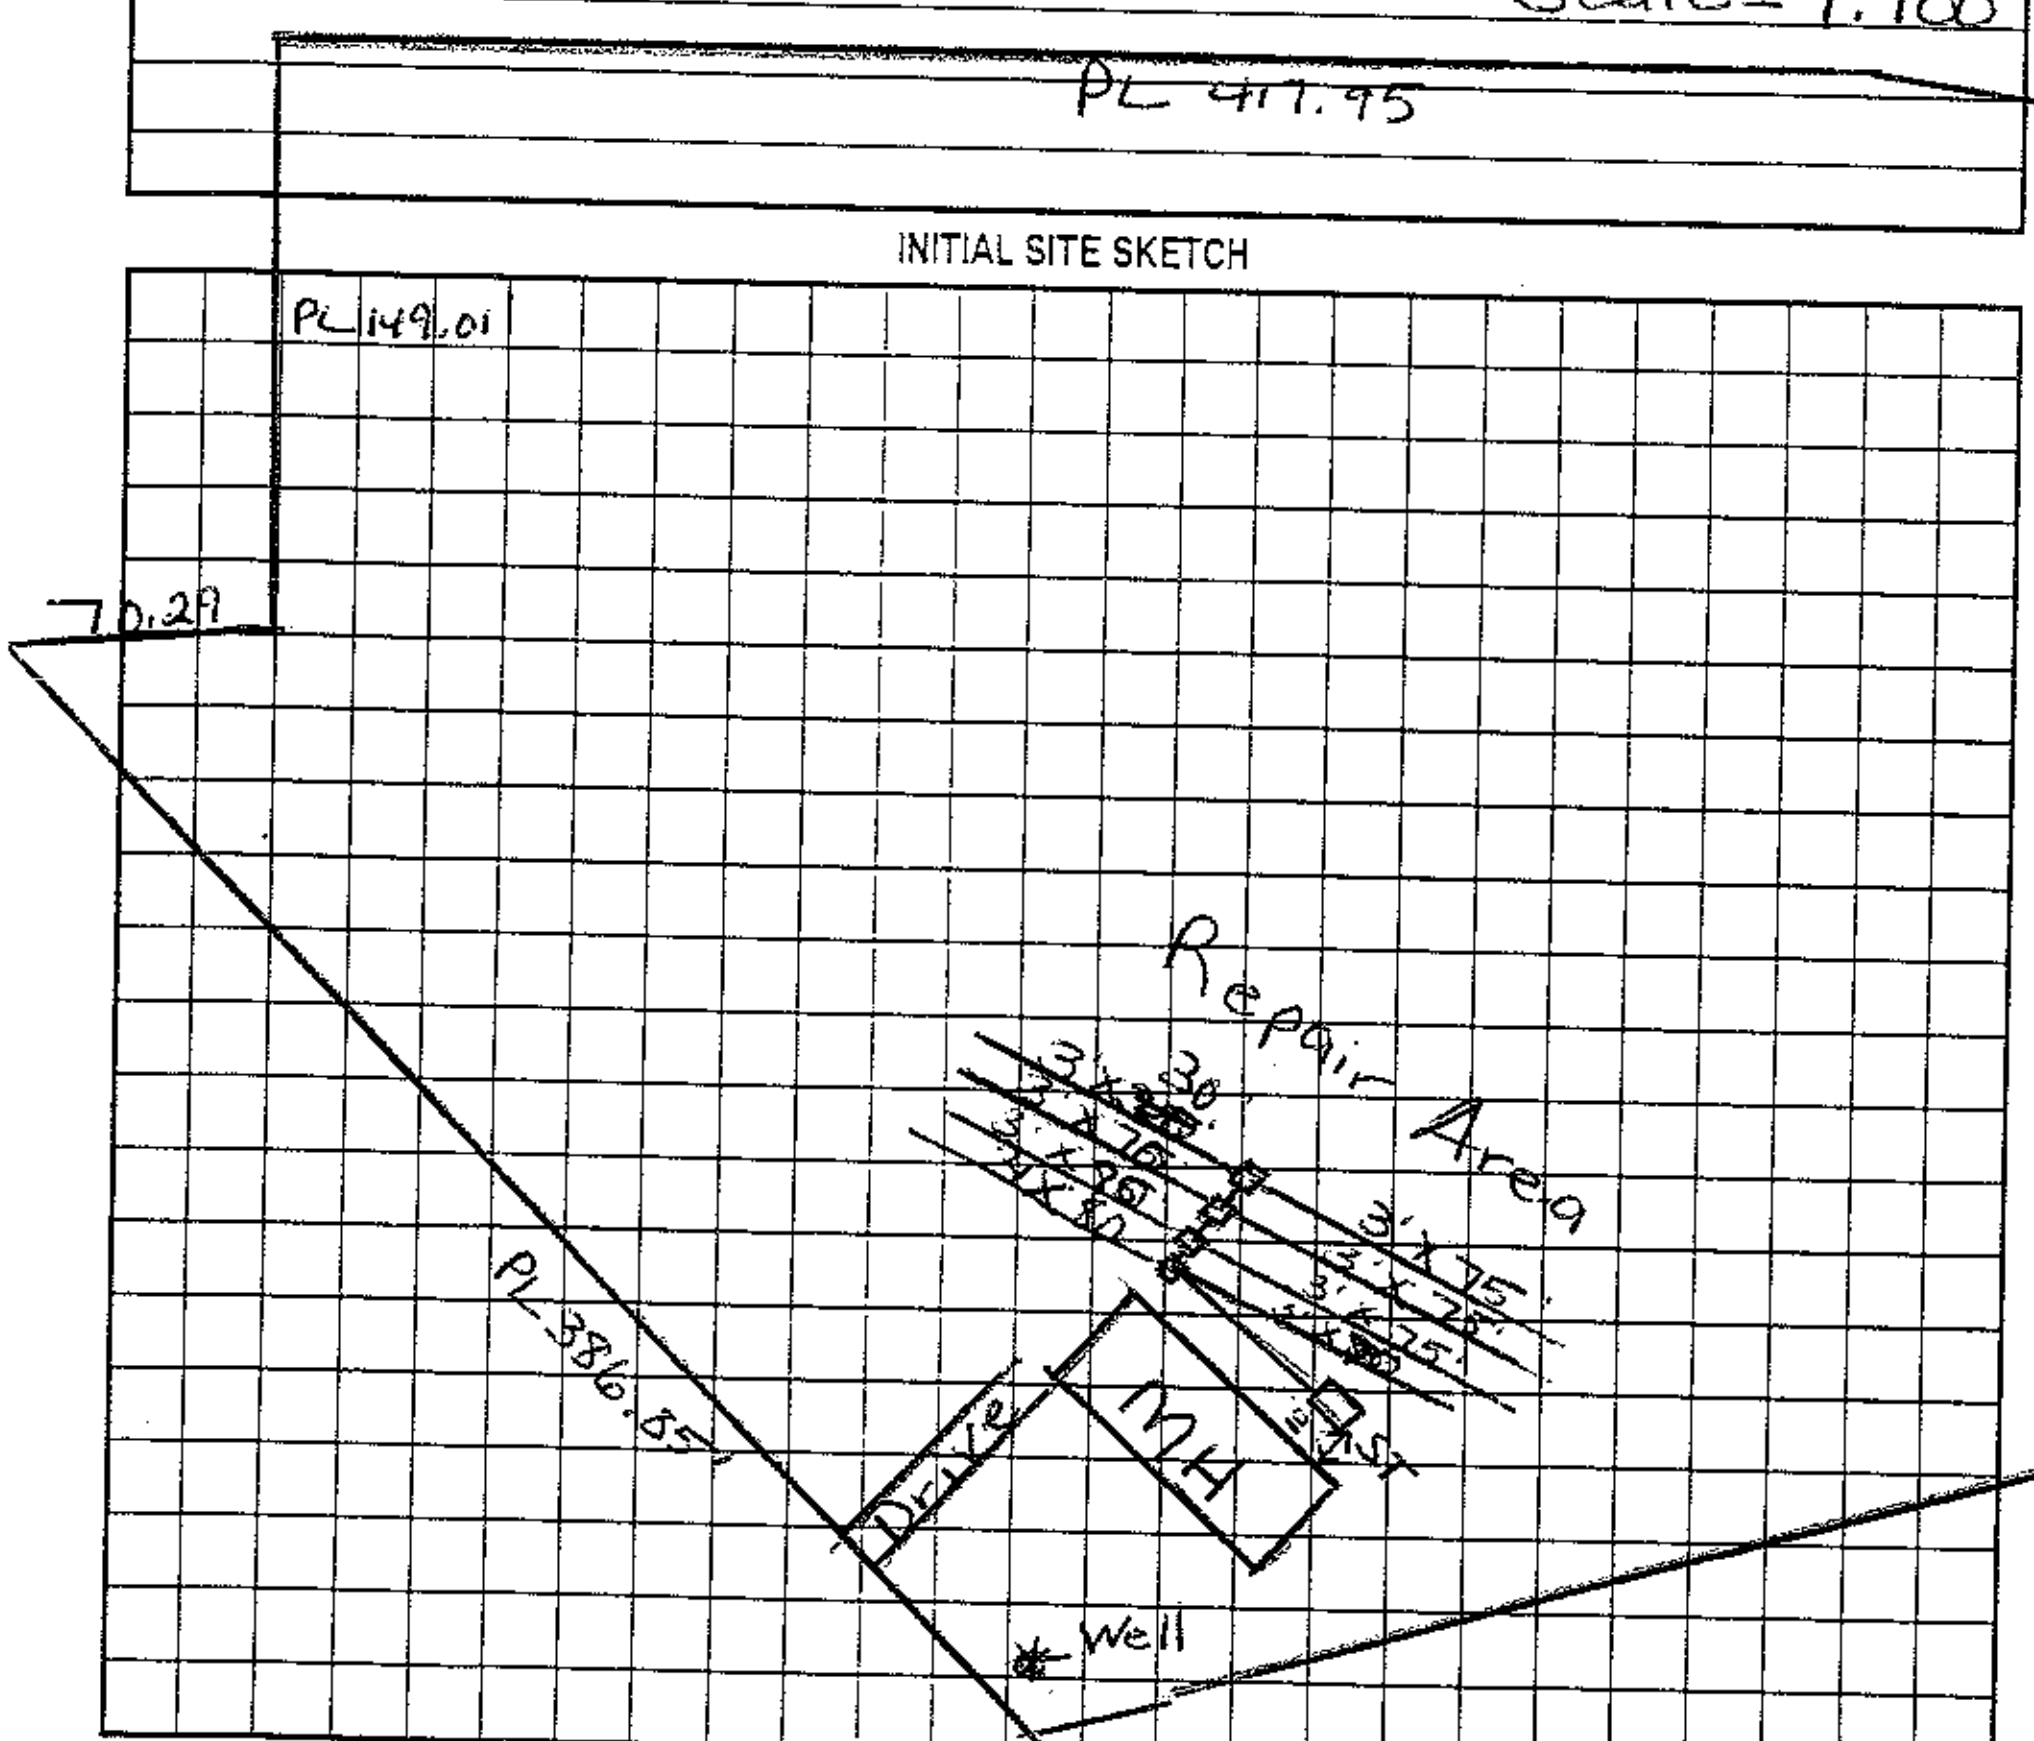

AS BUILT SKETCH

Permit can be suspended or revoked if any false information is supplied toward securing the permit/any unauthorized changes are made to the site/any unauthorized changes are made in the installation of the system. Improvement Permit with plat valid without expiration. Improvement Permit with site plan valid for sixty months. Authorization to Construct is valid for a period equal to that of Improvement Permit – not to exceed sixty months.

Signed: Jane L. Carson date 2/21/02 Installed by: Craig Thompson

Improvement Permit by: Maria H H Dobson RS date 2/21/2002 Operation Permit by: Maria H H Dobson RS date 2/22/2002

Authorization to Construct by: Maria H H Dobson RS date 2/21/2002 Existing System Inspection by: date

HEALTH DEPT. COPY: WHITE OWNER COPY (FINAL): YELLOW OWNER COPY (INITIAL): PINK