IREDELL COUNTY HEALTH DEPARTMENT

STATESVILLE 704-878-5305 (4) MOORESVILLE 704-664-5281

IMPROVEMENT PERMIT / AUTHORIZATION TO CONSTRUCT / OPERATION PERMIT / EXISTING SYSTEM INSPECTION

PERMIT# 119152 PIN# 4751-01-0531.000 0397 DATE 3-16-04

OWNER OR CONTRACTOR DARRELL T. HOUSTON PHONE: Business Home 704-528-1393

ADDRESS 229 OSTWALT AMITY ROAD TROUTMAN NC 28166

LOCATION US 21 SOUTH, TL OSTWALT AMITY ROAD TL EMMANUEL ROAD, 1ST LOT ON LEFT

SUBDIVISION BLOCK / SECTION LOT LOT AREA 2.196 ACRES SITE CLASS. PS DESIGN FLOW 360 L.T.A.R. 0.40 GAD/FT2

Septic Tank: 1000 Gallons; STB 1012 Date 10-17-03
Pump Tank: Gallons; PT Date
Pump Make: Model Serial No.
Nitrification Field: No Fields 1 Square Feet 900 Linear Feet 300
No Lines FIVE Trench Width 36" Max Trench Bottom Depth 36" Gravel Depth 12"

☑ New System ☐ Repair System Type: I, II, III, IV, V, VI
System Description: CONVENTIONAL, GRAVITY
Repair System Description: CONVENTIONAL, GRAVITY
Maintenance Agreement Required: ☐ Yes ☑ No


☑ House/Mod. Home No. Bedrooms 3
☐ Mobile Home No. Bathrooms 2
☐ Business No. Employees
☐ Other
☐ Slab ☑ Crawl Space ☐ Basement w/plumbing ☐ Basement wo/plumbing

Water Supply:
☑ Individual
☐ Public
☐ Community
WELL


Comments:/Conditions: KEEP SYSTEM MINIMUM 100' FROM WELLS

Comments:/Conditions: SEPTIC TANK WITH MARKER INSTALLED USING "TUFTITE" FILTER. SYSTEM ALTERED AS SHOWN DUE TO GAS LINE RIGHT-OF-WAY

INITIAL SITE SKETCH

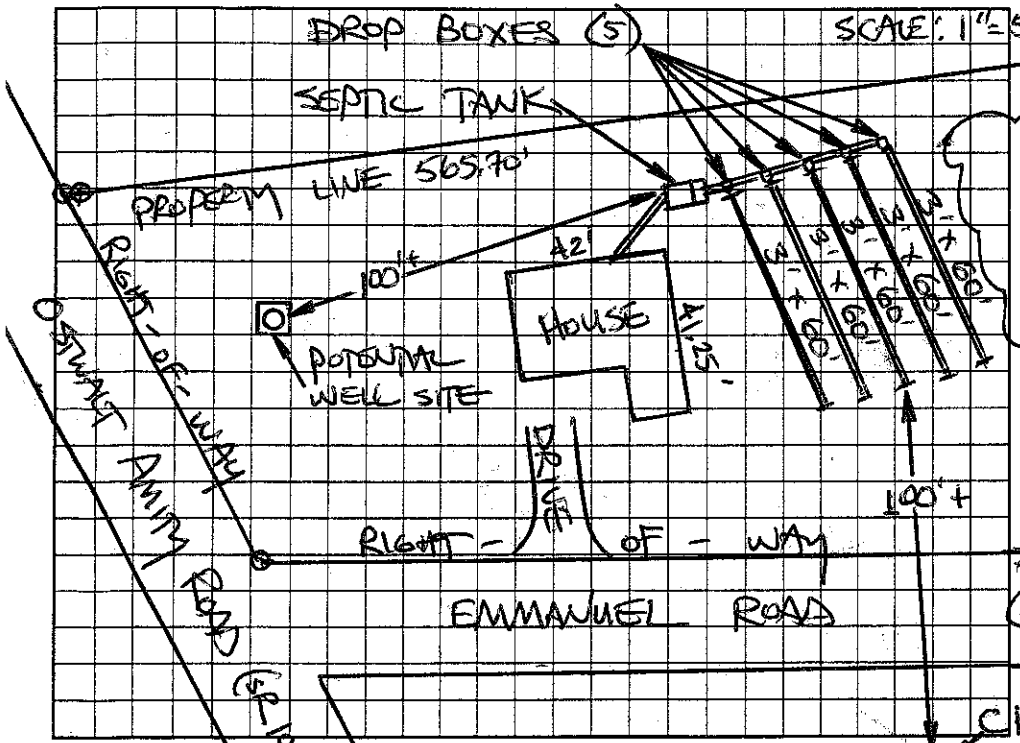

AS BUILT SKETCH

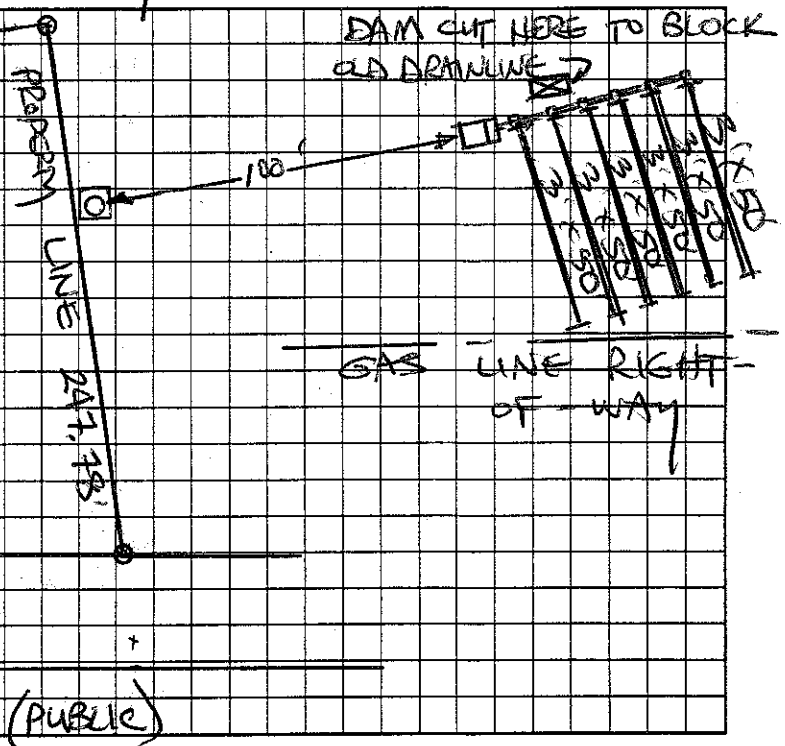

Permit can be suspended or revoked if any false information is supplied toward securing the permit/any unauthorized changes are made to the site/any unauthorized changes are made in the installation of the system. Improvement Permit with plat valid without expiration. Improvement Permit with site plan valid for sixty months. Authorization to Construct is valid for a period equal to that of Improvement Permit – not to exceed sixty months.

Signed: date 3-23-04 Installed by: C & S GRADING

Improvement Permit by: STEVE HENDRICK date 3-16-04 Operation Permit by: STEVE HENDRICK date 4-22-04

Authorization to Construct by: STEVE HENDRICK date 3-16-04 Existing System Inspection by: date

HEALTH DEPT. COPY: WHITE OWNER COPY (FINAL): YELLOW OWNER COPY (INITIAL): PINK