IREDELL COUNTY HEALTH DEPARTMENT

STATESVILLE 704-878-5305 MOORESVILLE 704-664-5281

IMPROVEMENT PERMIT / AUTHORIZATION TO CONSTRUCT / OPERATION PERMIT / EXISTING SYSTEM INSPECTION

PERMIT# 106141 PIN# 4751000748 / 4751011050 DATE 5/13/2002

OWNER OR CONTRACTOR Kristi Myers PHONE: Business 528-7755 Home Billy (Oakwood) 528-4516

ADDRESS 276 Oswalt Amity Rd Troutman, NC 28166

LOCATION Hwy 115 N TR Amity Hill just past I-77 bridge

SUBDIVISION J BLOCK / SECTION LOT J LOT AREA 1.0 Acre SITE CLASS. PS DESIGN FLOW 360 gpd L.T.A.R. .3

Septic Tank: 1000 Gallons: STB 794 Date 3-28-02
Pump Tank: Gallons: PT Date
Pump Make: Model Serial No.
Nitrification Field: No Fields 1 Square Feet 1200' Linear Feet 400'
No Lines 5 @ 80' Trench Width 36" Max Trench Bottom Depth 36"

☒ New System ☐ Repair System Type: I (II) III. IV. V. VI
System Description: Gravity - Conventional
Repair System Description: Gravity - Innovative
Maintenance Agreement Required: ☐ Yes ☒ No
Gravel Depth 12"


☐ House/Mod. Home ☒ Mobile Home ☐ Business ☐ Other
No. Bedrooms 3 No. Bathrooms 2 No. Employees
☐ Slab ☒ Crawl Space ☐ Basement w/plumbing ☐ Basement wo/plumbing

Water Supply: ☒ Individual ☐ Public ☐ Community


Comments:/Conditions: Must keep Septic System & well out of any Right of Way or Easement area. Keep Septic System 10' From PL

Comments:/Conditions: Keep well 40' from side property lines & 25' from house ★MH back 100' from road (Oswalt-Amity Rd) see drawing.

INITIAL SITE SKETCH Not to Scale

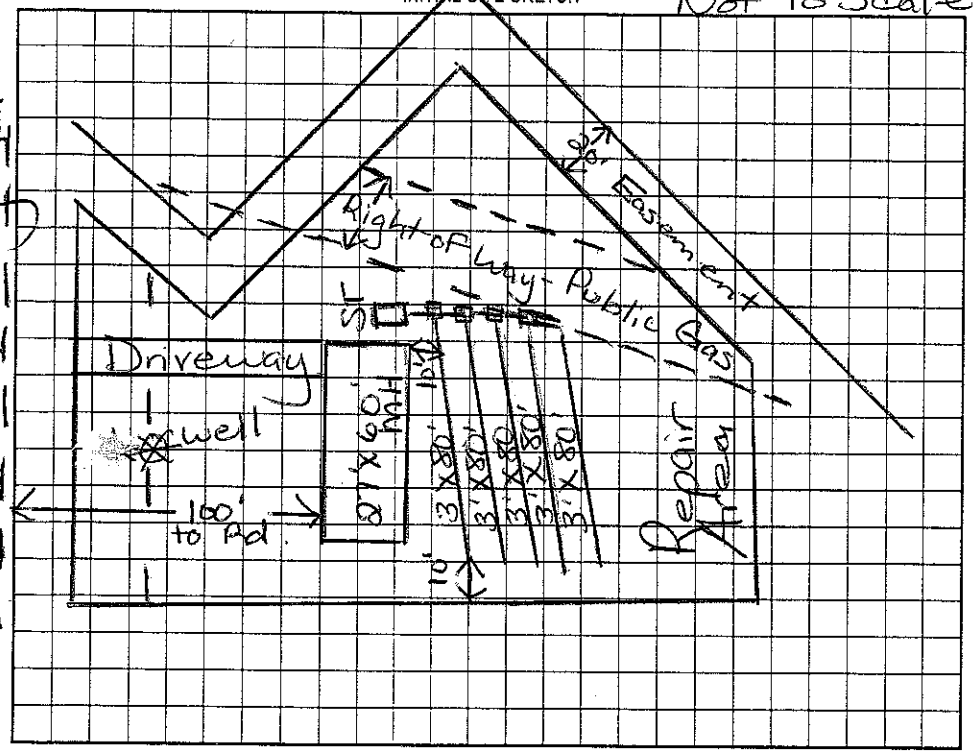

AS BUILT SKETCH

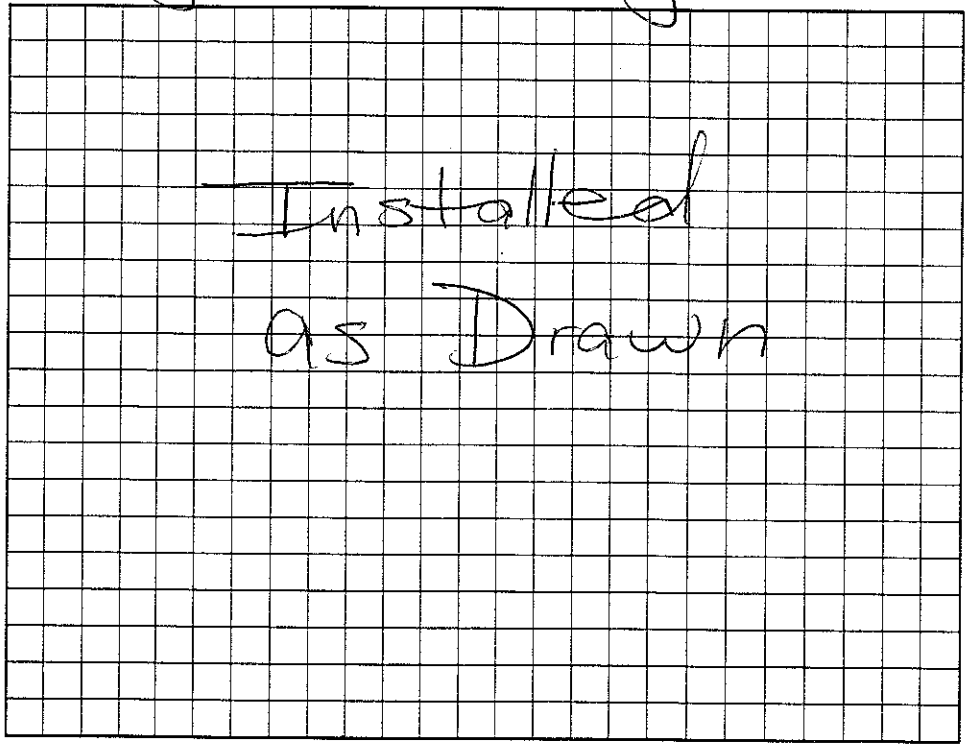

Permit can be suspended or revoked if any false information is supplied toward securing the permit/any unauthorized changes are made to the site/any unauthorized changes are made in the installation of the system. Improvement Permit with plat valid without expiration / Improvement Permit with site plan valid for sixty months. Authorization to Construct is valid for a period equal to that of Improvement Permit – not to exceed sixty months.

Signed: [signature] date 5/14/2002 Installed by: Craig Thompson

Improvement Permit by: Maria H. Dotson RS date 5/13/02 Operation Permit by: Maria H. Dotson date 5/15/2002

Authorization to Construct by: Maria H. Dotson RS date 5/13/02 Existing System Inspection by: date

HEALTH DEPT. COPY: WHITE OWNER COPY (FINAL): YELLOW OWNER COPY (INITIAL): PINK