IREDELL COUNTY HEALTH DEPARTMENT

STATESVILLE 704-878-5305 MOORESVILLE 704-664-5281

IMPROVEMENT PERMIT / AUTHORIZATION TO CONSTRUCT / OPERATION PERMIT / EXISTING SYSTEM INSPECTION

PERMIT# REPAIR PIN# 4751-01-2459 RICHARD GREEN DATE 03/18/03

OWNER OR CONTRACTOR BEULAH HEIGHTS WESLEYAN CHURCH PHONE: Business 704-528-0183 Home 704-528-4967

ADDRESS 108 EMANUEL RD. TROUTMAN, NC PAGER 704-838-9467

LOCATION I-I SOUTH, (E) OSWALT AMITY, (L) EMANUEL RD., CHURCH ON RIGHT, ON CORNER.

SUBDIVISION — BLOCK / SECTION — LOT — LOT AREA 0.65 ACRES SITE CLASS. REPAIR DESIGN FLOW 450 GPD L.T.A.R. REPAIR

Septic Tank: 1,000 Gallons; STB 1012 Date 08/12/02
Pump Tank: ____ Gallons; PT ____ Date ____
Pump Make: ____ Model EXISTING Serial No. ____
Nitrification Field: No Fields 1 Square Feet ~747.5 Linear Feet ~115
No Lines 1 BED Trench Width ~6½' Max Trench Bottom Depth ? Gravel Depth ?

☐ New System ☒ Repair System Type: I, (II), III, IV, V, VI
System Description: ____
Repair System Description: EXISTING, CONVENTIONAL
Maintenance Agreement Required: ☐ Yes ☒ No

☐ House/Mod. Home No. Bedrooms ____
☐ Mobile Home No. Bathrooms ____
☐ Business No. Employees ____
☒ Other CHURCH 150 SEATING


☐ Slab ☒ Crawl Space ☐ Basement w/plumbing ☐ Basement wo/plumbing

Water Supply: ☒ Individual ☐ Public ☐ Community EXISTING WELL

Comments/Conditions: (1) DISCONNECT & ABANDON EXISTING SEPTIC TANK, (2) CRUSH & FILL IN EXISTING SEPTIC TANK. (3) INSTALL A NEW 1,000 GALLON SEPTIC TANK & RUN A NEW COLLECTION SEWER TO TANK.

Comments/Conditions: - SEPTIC TANK INSTALLED USING TUFF-TIGHT FILTER & TANK MARKER

INITIAL SITE SKETCH

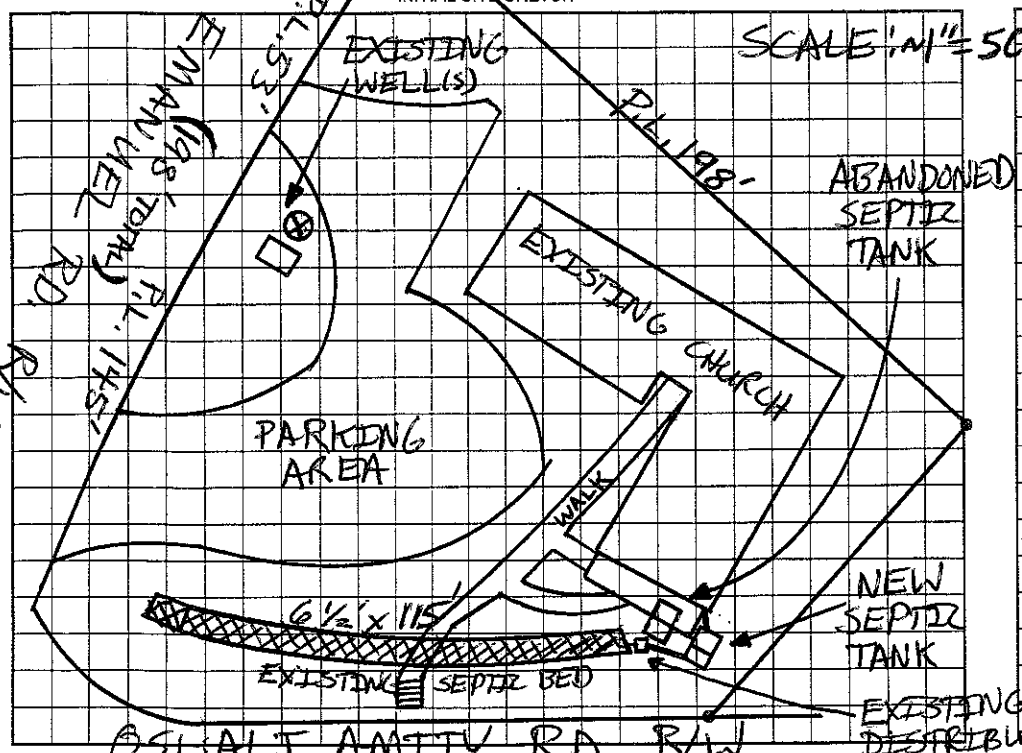

AS BUILT SKETCH

INSTALLED AS SHOWN IN INITIAL SITE SKETCH.

Permit can be suspended or revoked if any false information is supplied toward securing the permit/any unauthorized changes are made to the site/any unauthorized changes are made in the installation of the system. Improvement Permit with plat valid without expiration. Improvement Permit with site plan valid for sixty months. Authorization to Construct is valid for a period equal to that of Improvement Permit – not to exceed sixty months.

X Signed: Richard Kilgore date 3-18-03 Installed by: STEVE JORDAN 03/27/03

Improvement Permit by: Patrick Mitchell date 03/18/03 Operation Permit by: Patrick Mitchell date 03/27/03

Authorization to Construct by: Patrick Mitchell date 03/18/03 Existing System Inspection by: ____ date ____

HEALTH DEPT. COPY: WHITE OWNER COPY (FINAL): YELLOW OWNER COPY (INITIAL): PINK