2:00

IREDELL COUNTY HEALTH DEPARTMENT

STATESVILLE 704-878-5305 MOORESVILLE 704-664-5281

IMPROVEMENT PERMIT / AUTHORIZATION TO CONSTRUCT / OPERATION PERMIT / EXISTING SYSTEM INSPECTION

PERMIT # REPAIR PIN # 4751-01-9635 DATE 12-16-08

OWNER or APPLICANT KENNETH OVERCASH PHONE: Business 704-528-5858 Home:

OWNER or APPLICANT ADDRESS 408 OSWALT AMITY RD

LOCATION / DIRECTIONS 21N, TR OSWALT AMITY, ON R

SUBDIVISION — BLOCK / SECTION — LOT # — LOT AREA 1.56AC DESIGN FLOW 240 L.T.A.R. .3

Septic Tank EXISTING Gallons: STB Date

Pump Tank Gallons: P T Date

Pump Make Model Serial #

Nitrification Field No Fields 1 No Lines 2 Linear Feet 300'

Trench Width 36" Max. Trench Bottom Depth 36" Gravel Depth 12"

☐ New System ☒ Repair ☐ Expansion System Type I (II) III IV V VI

System Description:

Repair System Description: GRAVITY 25%

Maintenance Agreement Required ☐ YES ☒ NO

☒ GRAVITY ☐ PRESSURE

☒ Residence No. Bedrooms 2

☐ Business No. Persons

☐ Other No. Employees

☐ Slab ☒ Crawl Space

☐ Basement w/plumbing ☐ Basement w/o plumbing


Water Supply: ☒ Private ☐ Public ☐ Community

Comments / Conditions 1) LINES MUST BE 50' FROM WELL 2) INSTALL 1 LINE ON EACH SIDE OF BERM @ 150' 3) MAKE SURE TOP LINE IS NOT IN DRAINAGE DITCH


Comments / Conditions 28 CHAMBERS EACH DITCH

28

INITIAL SITE SKETCH

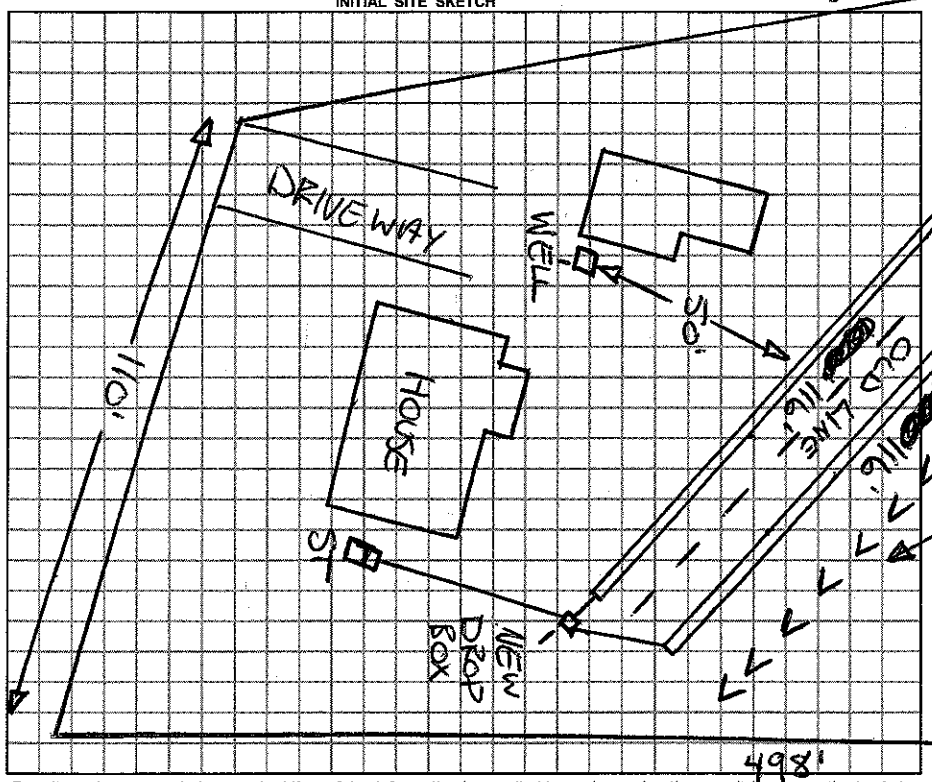

AS BUILT SKETCH

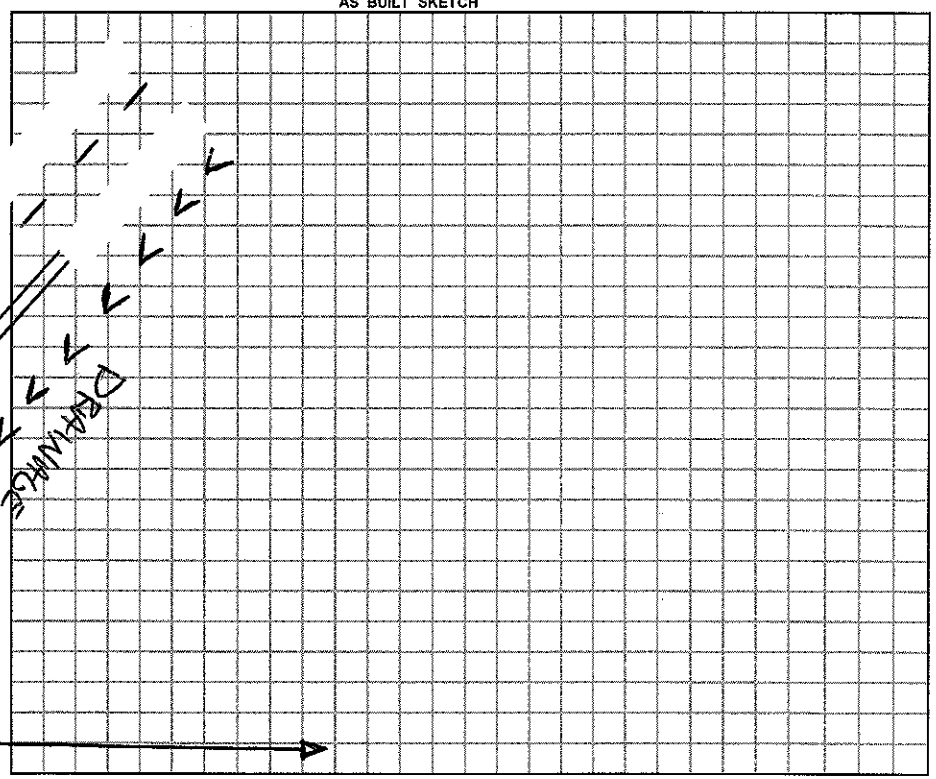

Permit can be suspended or revoked if any false information is supplied toward securing the permit / any unauthorized changes are made to the site / any unauthorized changes are made in the installation of the system.

☐ *IMPROVEMENT PERMIT w / plat valid without expiration.* ☒ *IMPROVEMENT PERMIT w / site plan valid for 60 mos.* ☒ *AUTHORIZATION TO CONSTRUCT valid for period equal to IMPROVEMENT PERMIT-not to exceed 60 mo.*

Owner / Applicant Signature: Kenneth Overcash Date 12/16/08

Improvement Permit by: JR-A Date 12-16-08

Authorzation to Construct by: JR-A Date 12-16-08

Installed by:

Operation Permit by: JR-A Date: 1-5-09

Existing System Inspected by: Date:

YOU SHOULD CONTACT A LOCATOR SERVICE PRIOR TO ANY EXCAVATION.

WHITE COPY Environmental Health YELLOW COPY (Final) Owner / Applicant PINK COPY (Initial) Owner / Applicant