IREDELL COUNTY HEALTH DEPARTMENT

STATESVILLE 704-878-5305 MOORESVILLE 704-664-5281

IMPROVEMENT PERMIT / AUTHORIZATION TO CONSTRUCT / OPERATION PERMIT / EXISTING SYSTEM INSPECTION

PERMIT# 146575 PIN# 4751-02-2510 1575 DATE 12-31-07

OWNER OR APPLICANT FREEDOM HOMES - STATESVILLE #669 PHONE: Business 704-872-0179 Home

ADDRESS 1270 NORTHSIDE DRIVE, STATESVILLE, NC 28677

LOCATION US 21 SOUTH, TL OSWALT AMITY ROAD TL EMMANUEL ROAD, AT END ON RIGHT

SUBDIVISION BLOCK / SECTION LOT 1 LOT AREA 1.53 ACRES 0.48 ACRE SITE CLASS. P3 DESIGN FLOW 600 GPD L.T.A.R. EXISTING

Septic Tank: 2400 Gallons: STB Date

Pump Tank: Gallons: PT Date

Pump Make: Model Serial No.

Nitrification Field: No Fields 1 Square Feet Linear Feet EXISTING

No Lines FIVE Trench Width Max Trench Bottom Depth Gravel Depth

☐ New System ☐ Repair ☐ Expansion System Type: I II (III) IV V VI

System Description: CONV. GRAVITY

Repair System Description:

Maintenance Agreement Required: ☐ Yes ☒ No

☐ House/Mod. Home ☒ Mobile Home ☐ Business ☐ Other

No. Bedrooms 3 No. Persons No. Employees


Water Supply: ☒ Individual ☐ Public ☐ Community WELL

☒ Gravity ☐ Pressure ☐ Slab ☒ Crawl Space ☐ Basement w/plumbing ☐ Basement wo/plumbing


Comments:/Conditions:

Comments:/Conditions: (1) SYSTEM SIZED TO ACCOMODATE FIVE BEDROOMS MAXIMUM (SEE ATTACHED PERMIT of OCTOBER 12, 1988 (2) SEE ATTACHED DEED of EASEMENT FOR CROSSING PROPERTY LINE.

INITIAL SITE SKETCH

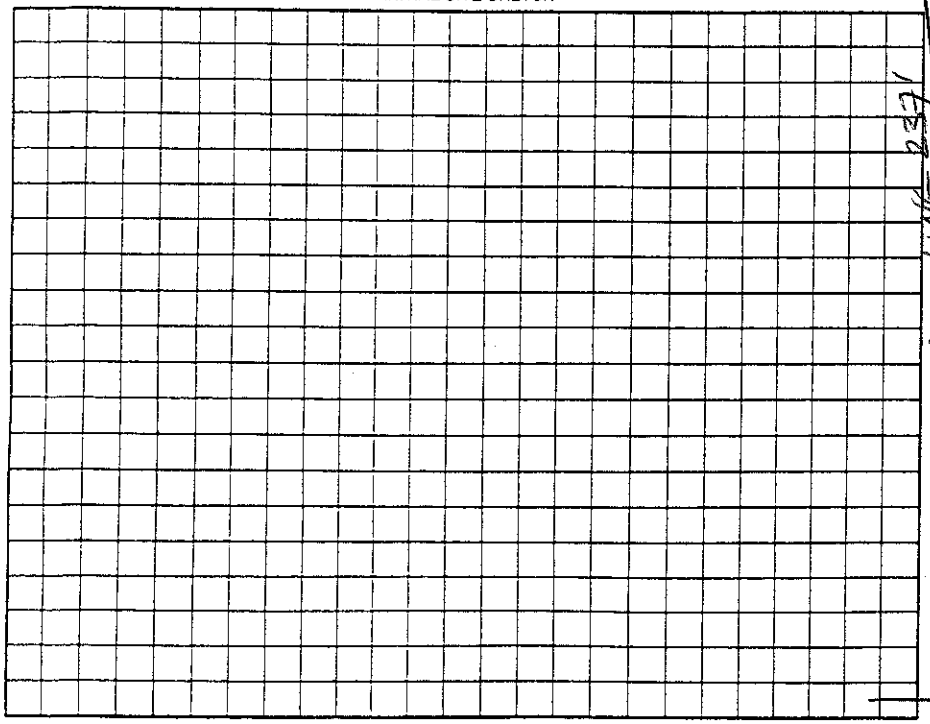

AS BUILT SKETCH

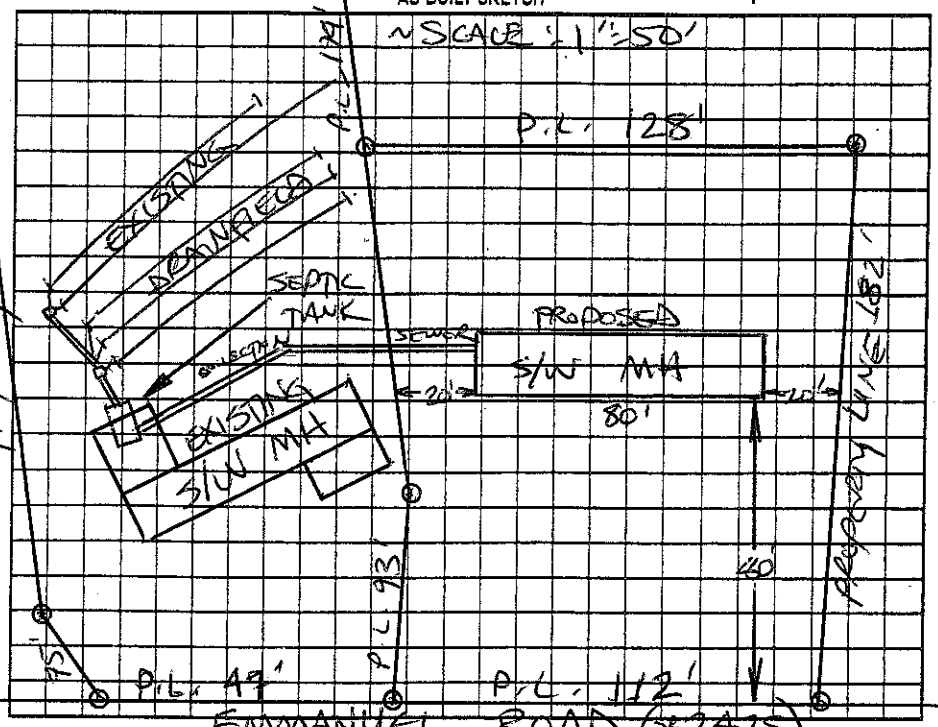

Permit can be suspended or revoked if any false information is supplied toward securing the permit/any unauthorized changes are made to the site/any unauthorized changes are made in the installation of the system. Improvement Permit with plat valid without expiration ☐ Improvement Permit with site plan valid for sixty months ☐ Authorization to Construct is valid for a period equal to that of Improvement Permit – not to exceed sixty months.

Signed: date 12-31-07 Installed by:

Improvement Permit by: date Operation Permit by: date

Authorization to Construct by: date Existing System Inspection by: STEVE HEDRICK date 12-31-07

HEALTH DEPT. COPY: WHITE OWNER COPY (FINAL): YELLOW OWNER COPY (INITIAL): PINK