IREDELL COUNTY HEALTH DEPARTMENT

STATESVILLE 704-878-5305 (1) MOORESVILLE 704-664-5281

IMPROVEMENT PERMIT / AUTHORIZATION TO CONSTRUCT / OPERATION PERMIT / EXISTING SYSTEM INSPECTION

PERMIT# 115315 PIN# ~~4751-03-9080.001~~ 4751-02-6805 DATE 9-8-03

OWNER OR CONTRACTOR CIRCLE B. CONSTRUCTION PHONE: Business 704-309-5564 Home 704-663-4448

ADDRESS 1042 N. MAIN STREET MOORESVILLE NC 28115

LOCATION US 21 SOUTH, TL OSWALT-AMITY ROAD, ON LEFT PAST STILLMEADOW LANE AT #401

SUBDIVISION ______ BLOCK / SECTION ______ LOT ______ LOT AREA 5.37 ACRES SITE CLASS. PS DESIGN FLOW 360 L.T.A.R. 0.25 GPD/FT²

Septic Tank: 1000 Gallons; STB 1012 Date 7-28-03
Pump Tank: ______ Gallons; PT ______ Date ______
Pump Make: ______ Model ______ Serial No. ______
Nitrification Field: No Fields 1 Square Feet 1440 Linear Feet 480
No Lines FOUR Trench Width 36 ~~Max~~ MIN Trench Bottom Depth 36" Gravel Depth 12"

☒ New System ☐ Repair System Type: I (II) III, IV, V, VI
System Description: CONVENTIONAL, GRAVITY
Repair System Description: 25% REDUCTION, PUMP
Maintenance Agreement Required: ☐ Yes ☒ No

☒ House/Mod. Home ☐ Mobile Home ☐ Business ☐ Other
No. Bedrooms 3
No. Bathrooms 2
No. Employees ______


Water Supply: ☒ Individual ☐ Public ☐ Community

☐ Slab ☐ Crawl Space ☒ Basement w/plumbing ☐ Basement wo/plumbing


Comments:/Conditions: INSTALL LINES ON CONTOUR AS FLAGGED AS 36 INCHES DEEP (NO LESS)

Comments:/Conditions: (1) SEPTIC TANK WITH MARKER INSTALLED USING "TUFTITE" FILTER (2) SYSTEM INSTALLED DURING PERIOD OF WET SOIL CONDITIONS

INITIAL SITE SKETCH

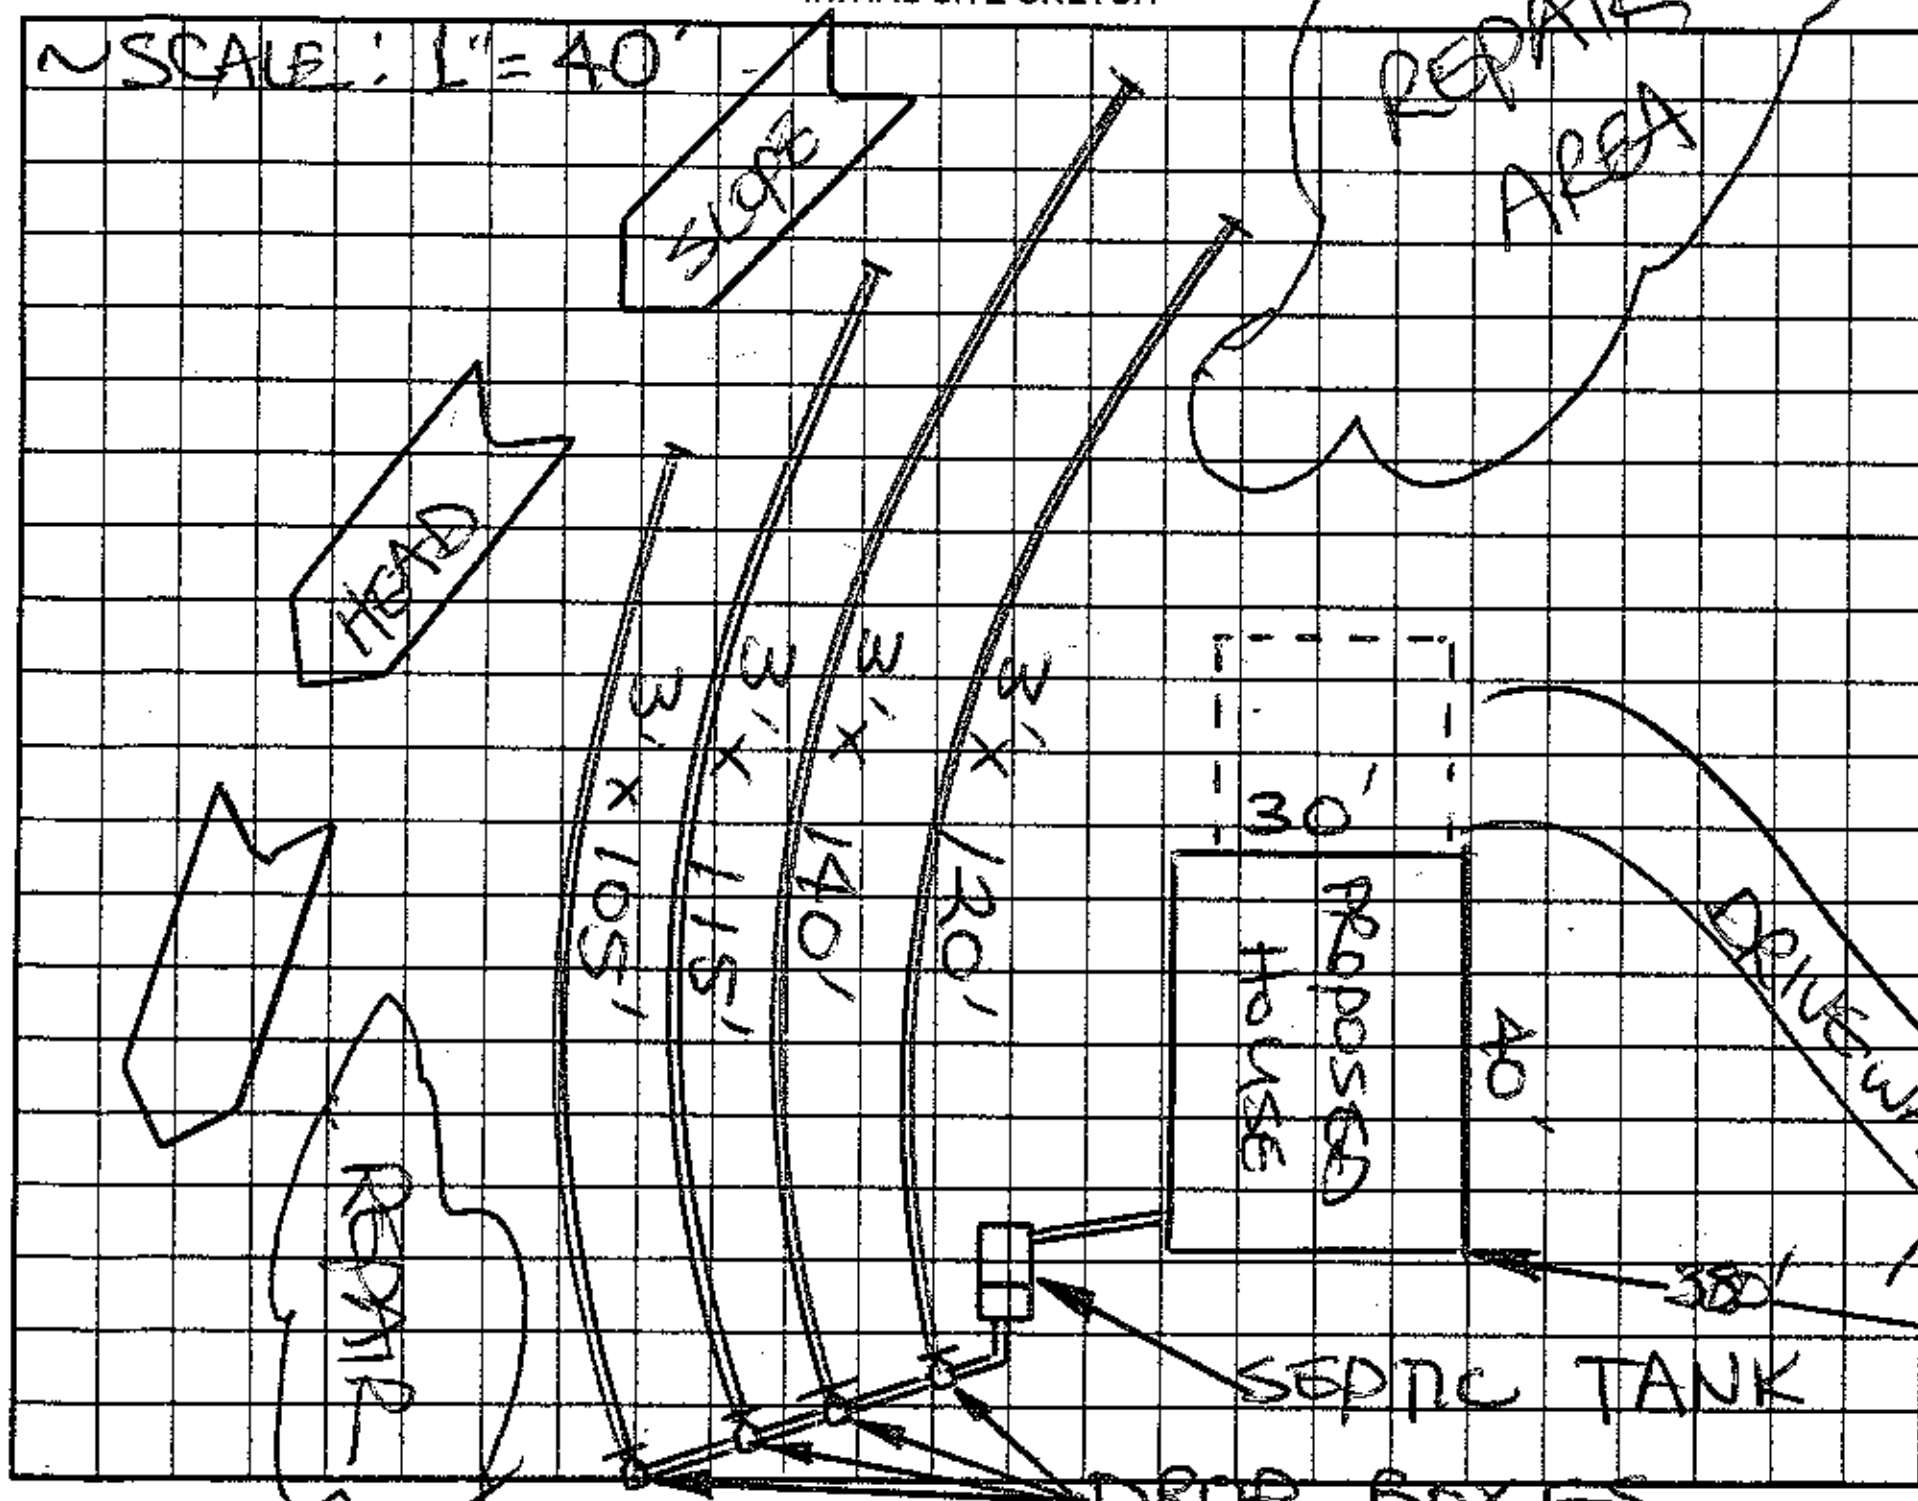

AS BUILT SKETCH

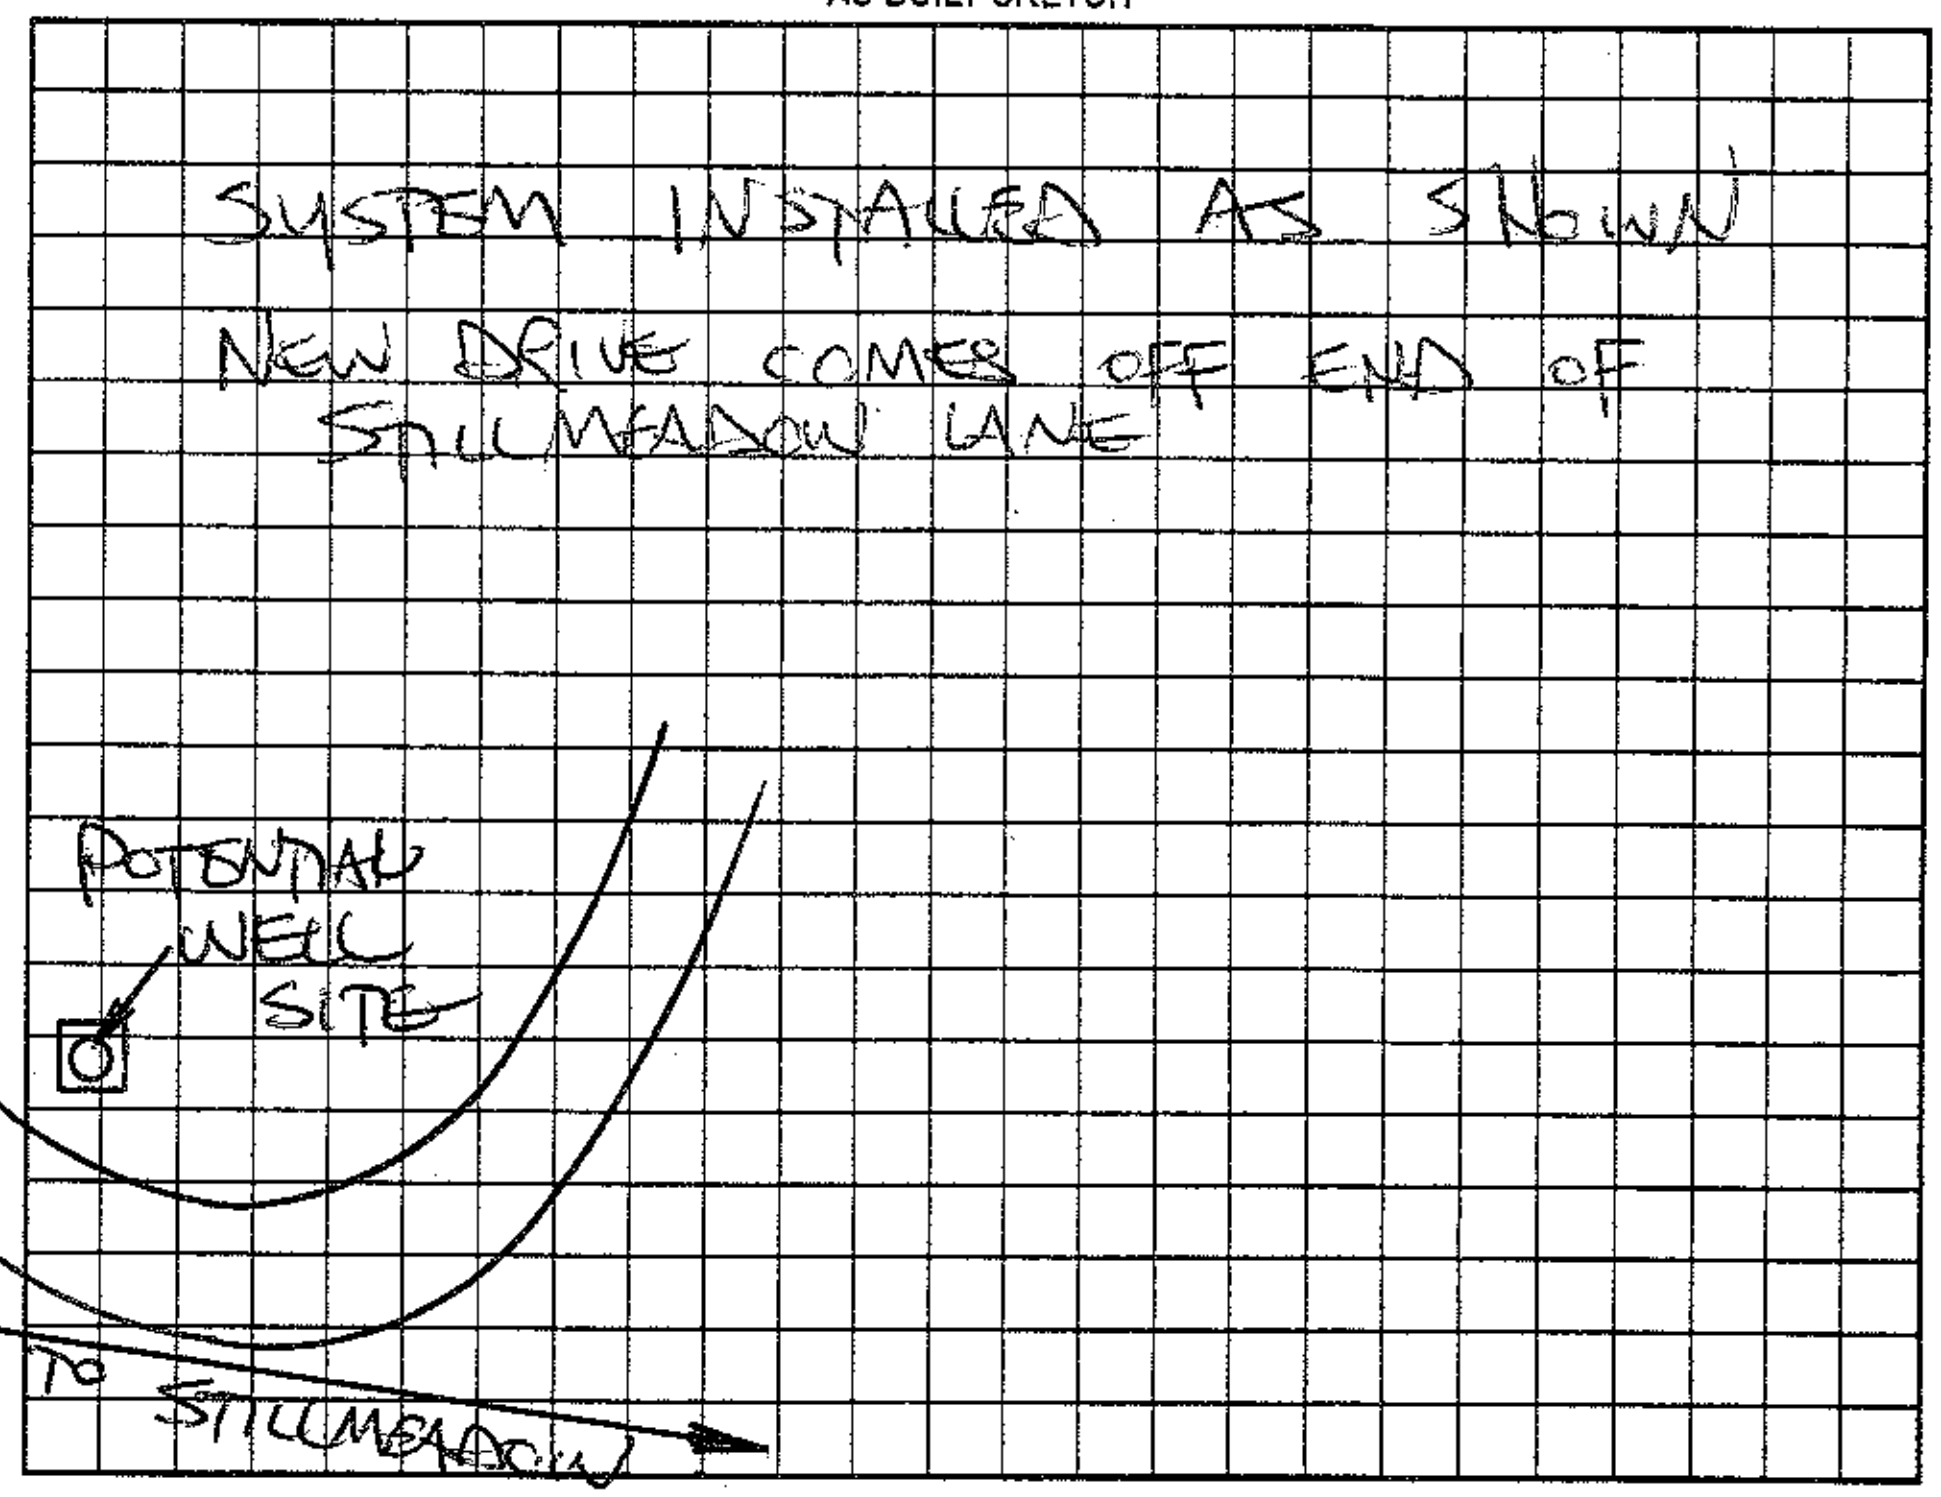

Permit can be suspended or revoked if any false information is supplied toward securing the permit/any unauthorized changes are made to the site/any unauthorized changes are made in the installation of the system. Improvement Permit with plat valid without expiration. Improvement Permit with site plan valid for sixty months. Authorization to Construct is valid for a period equal to that of Improvement Permit – not to exceed sixty months.

Signed: [signature] date 9-8-03 Installed by: CRAIG THOMPSON

Improvement Permit by: STEVE HEDRICK date 9-8-03 Operation Permit by: STEVE HEDRICK date 1-6-04

Authorization to Construct by: STEVE HEDRICK date 9-8-03 Existing System Inspection by: ______ date ______

HEALTH DEPT. COPY: WHITE OWNER COPY (FINAL): YELLOW OWNER COPY (INITIAL): PINK