IREDELL COUNTY HEALTH DEPARTMENT

STATESVILLE 704-878-5305 MOORESVILLE 704-664-5281

IMPROVEMENT PERMIT / CERTIFICATE OF COMPLETION / OPERATION PERMIT / EXISTING SYSTEM INSPECTION

PROPERTY DESCRIPTION NO. 25832 DATE 1-17-97 TAX MAP NO. 4751 02 7310 Watershed: ☐ Yes ☑ No

OWNER OR CONTRACTOR Robert Gallihen PHONE: Business Home 528-4906

ADDRESS 357 Oswalt Amity Road · Troutman

LOCATION 215 ft. 100 ft. New Street

SUBDIVISION Still Meadows BLOCK / SECTION LOT 12 LOT AREA 21,397.31 SITE CLASS PS DESIGN FLOW 360 L.T.A.R. .25

Septic Tank: 1000 Gallons; STB 1012 Date 1-24-97

Pump Tank: Gallons; PT Date

Pump Make: Model Serial No.

Nitrification Field: No Fields 1 Square Feet Linear Feet 240

No Lines 3 Trench Width 24" Max Trench Bottom Depth 36" Gravel Depth N/A

☑ New System ☐ Repair System Type: I II III IV V VI

System Description: Gravity Panels

Repair System Description: II II

Maintenance Agreement Required: ☐ Yes ☑ No

☐ Slab ☑ Crawl Space ☐ Basement w/plumbing ☐ Basement wo/plumbing

☐ House/Mod. Home No. Bedrooms 3

☑ Mobile Home No. Bathrooms 2

☐ Business No. Employees

☐ Other


Water Supply: ☑ Individual ☐ Community ☐ Public

Comments:


Use 3" Pipe out of Dist box Reduce Then To 2" and use Speed Levelers In 3" Pipe

Comments:

INITIAL SITE SKETCH

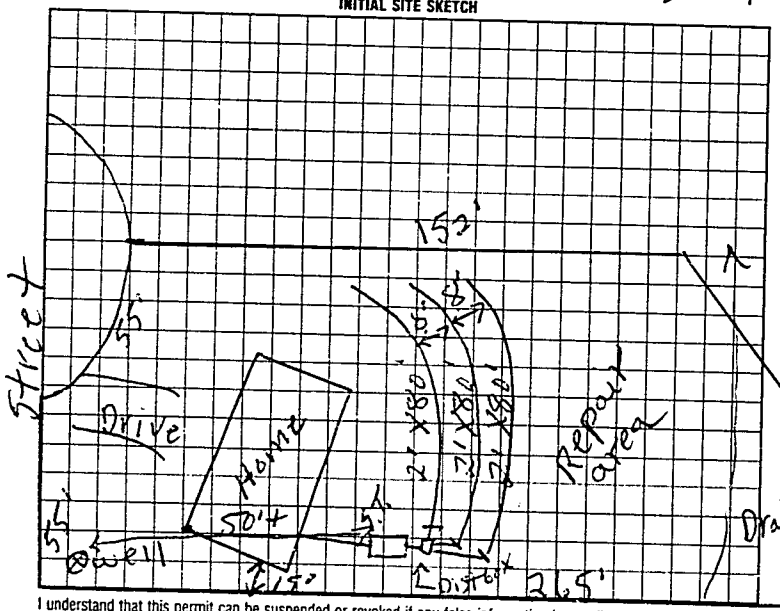

AS BUILT SKETCH

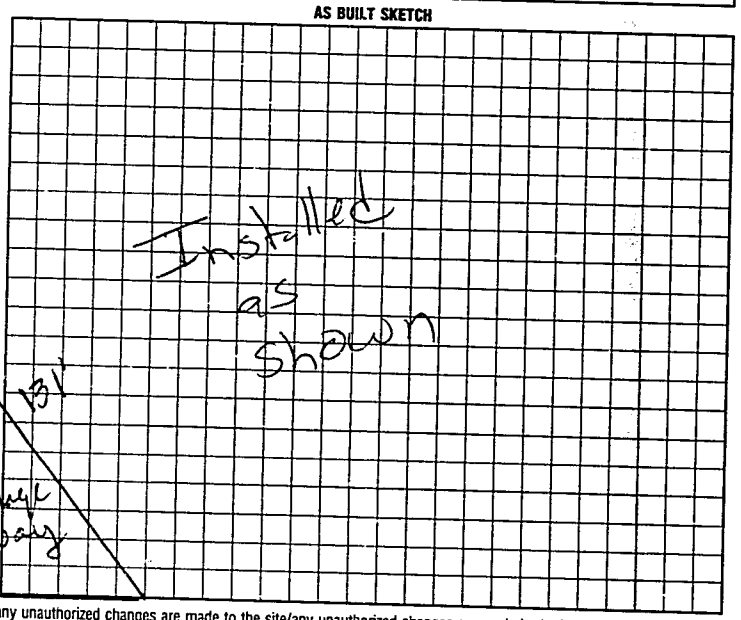

I understand that this permit can be suspended or revoked if any false information is supplied toward securing the permit/any unauthorized changes are made to the site/any unauthorized changes are made in the installation of the system. Improvement Permit is valid for 60 months from date of issuance.

Signed: Robert A. Gallihen

Improvement Permit by: L.C. Moore date 1-17-97

Authorization ~~Existing System Inspection~~ by: L.C. Moore date 1-17-97

To Const.

Installed by: A-1 Backhoe

Certificate of Completion by: date

Operation Permit by: May Cot PS date 4-9-97

HEALTH DEPT. COPY: WHITE INSPECTION COPY (FINAL): GREEN OWNER COPY (FINAL): YELLOW INSPECTION COPY (INITIAL): PINK OWNER COPY (INITIAL): GOLD

Authorization to Const. Expires 60 mos. from issue