IREDELL COUNTY HEALTH DEPARTMENT

STATESVILLE 704-878-5305 MOORESVILLE 704-664-5281

IMPROVEMENT PERMIT / CERTIFICATE OF COMPLETION / OPERATION PERMIT / EXISTING SYSTEM INSPECTION

PROPERTY DESCRIPTION NO. 25832 DATE 1-17-97 TAX MAP NO. 4751 02 7310 Watershed: ☐ Yes ☑ No

OWNER OR CONTRACTOR Robert Gallihen PHONE: Business Home 528-4906

ADDRESS 357 Oswalt Amity Road Troutman

LOCATION 215 to 100 TL New Street

SUBDIVISION Still meadows BLOCK / SECTION LOT 12 LOT AREA 21,397.31 SITE CLASS. PS DESIGN FLOW 360 L.T.A.R. .25

Septic Tank: 1000 Gallons; SIB 1012 Date 1-24-97

Pump Tank: Gallons; PT Date

Pump Make: Model Serial No.

Nitrification Field: No Fields 1 Square Feet Linear Feet 240

No Lines 3 Trench Width 24" Max Trench Bottom Depth 36" Gravel Depth N/A

☑ New System ☐ Repair System Type: Conv. I, V, VI

System Description: Gravity Panels

Repair System Description: " "

Maintenance Agreement Required: ☐ Yes ☑ No

☐ House/Mod. Home ☑ Mobile Home ☐ Business ☐ Other

No. Bedrooms 3 No. Bathrooms 2 No. Employees

☐ Slab ☑ Crawl Space ☐ Basement w/plumbing ☐ Basement wo/plumbing


Water Supply: ☑ Individual ☐ Community ☐ Public

Comments:

Use 3" Pipe out of Dist box Reduce Then To 2" and use 6 speed levelers In 3" Pipe

Comments:

INITIAL SITE SKETCH

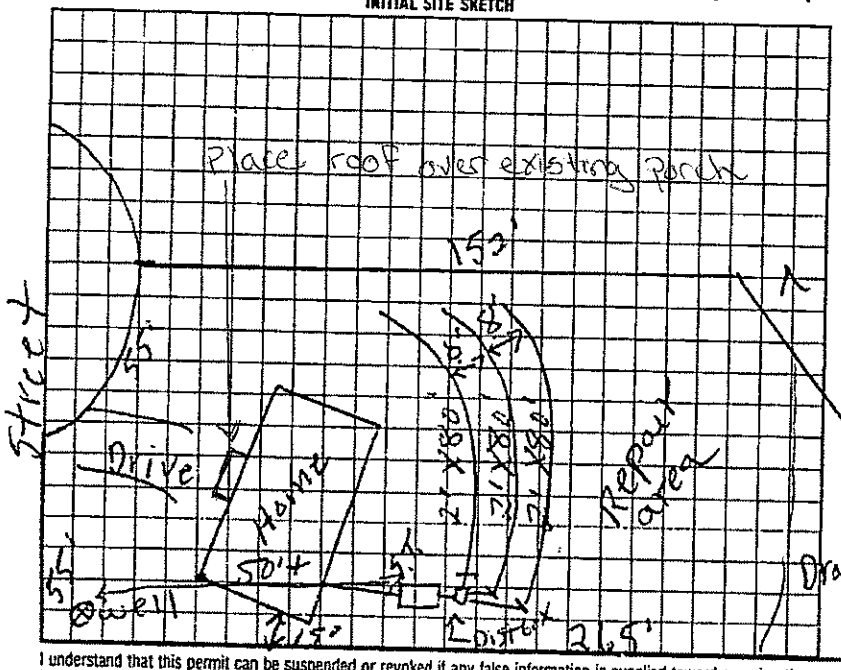

AS BUILT SKETCH

Location of the proposed roof over existing porch addition does not appear to impact the existing on-site septic system.**NOTE:

Justin Henderson REHS

Date: 11-1-13

ICHD-Environmental Health Division

I understand that this permit can be suspended or revoked if any false information is supplied toward securing the permit/any unauthorized changes are made to the site/any unauthorized changes are made in the installation of the system. Improvement Permit is valid for 60 months from date of issuance.

Signed: Robert D. Gallihen

Improvement Permit by: F.C. Moore date 1-17-97

Authorization Existing System Inspection by: F.C. Moore date 1-17-97

Installed by: A-1 Backhoe

Certificate of Completion by: date

Operation Permit by: Mel Cutts date 4-9-97

HEALTH DEPT COPY: WHITE INSPECTION COPY (FINAL): GREEN OWNER COPY (FINAL): YELLOW INSPECTION COPY (INITIAL): PINK OWNER COPY (INITIAL): GOLD

Authorization to Const. Expires 60 mos. from 1-17-97

1 Const.