IREDELL COUNTY HEALTH DEPARTMENT

STATESVILLE 704-878-5305 MOORESVILLE 704-664-5281

IMPROVEMENT PERMIT / CERTIFICATE OF COMPLETION / OPERATION PERMIT / EXISTING SYSTEM INSPECTION

PROPERTY DESCRIPTION NO. 25835 DATE 1-17-97 TAX MAP NO. 4751 02 7310 Watershed: ☐ Yes ☑ No

OWNER OR CONTRACTOR Robert Galliher PHONE: Business _____ Home 528-4906

ADDRESS 357 Oswalt Amity Road

LOCATION 215 TL ~~Annie~~ Oswalt Amity past Stillmeadow 1st lot left

SUBDIVISION Stillmeadow BLOCK / SECTION _____ LOT 15 LOT AREA 20800 SF SITE CLASS. PS DESIGN FLOW 360 L.T.A.R. .125

Septic Tank: 1000 Gallons; STB 1017 Date 8-24-97

Pump Tank: _____ Gallons; PT _____ Date _____

Pump Make: _____ Model _____ Serial No. _____

Nitrification Field: No Fields 1 Square Feet _____ Linear Feet 240

No Lines 3 Trench Width 24" Max Trench Bottom Depth 36" Gravel Depth N/A

☑ New System ☐ Repair System Type: I, II, III, IV, V, VI

System Description: Gravity Panels

Repair System Description: " "

Maintenance Agreement Required: ☐ Yes ☑ No

☐ House/Mod. Home ☑ Mobile Home ☐ Business ☐ Other

No. Bedrooms 3 No. Bathrooms 2 No. Employees ____


☐ Slab ☑ Crawl Space ☐ Basement w/plumbing ☐ Basement wo/plumbing

Water Supply: ☑ Individual ☐ Community ☐ Public


Comments:

Comments:

INITIAL SITE SKETCH

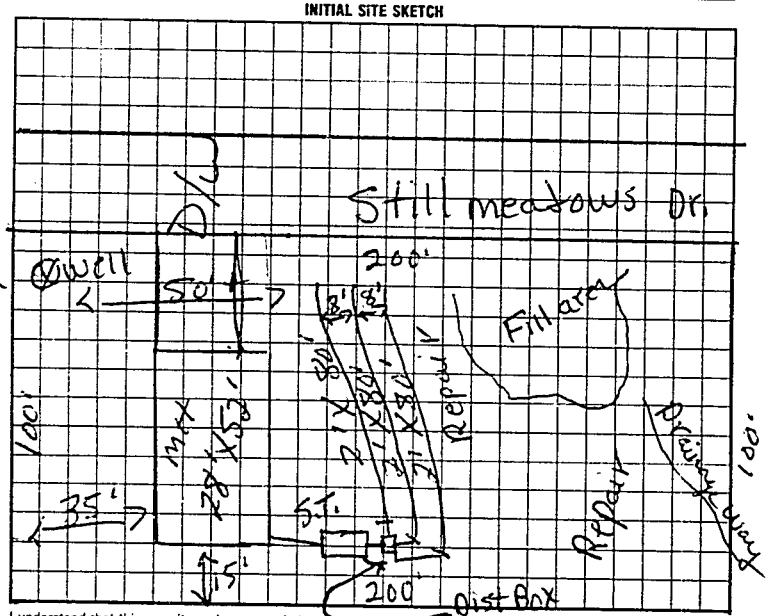

AS BUILT SKETCH

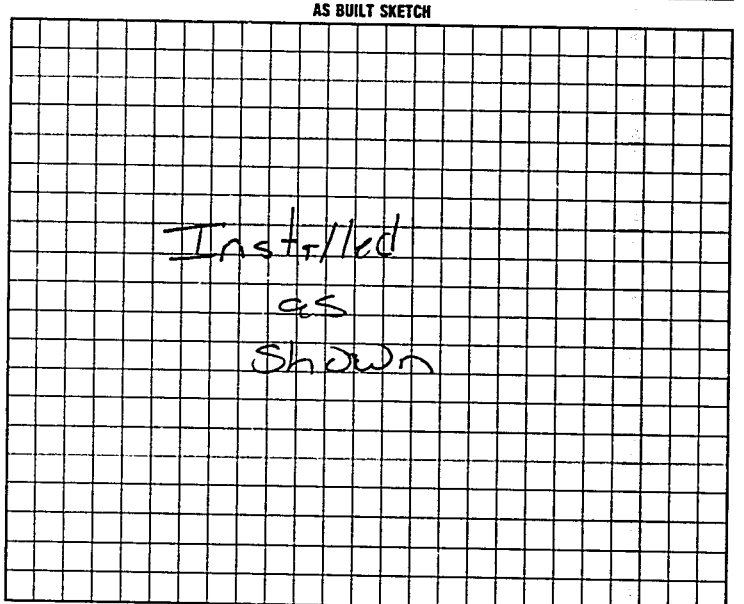

I understand that this permit can be suspended or revoked if any false information is supplied toward securing the permit/any unauthorized changes are made to the site/any unauthorized changes are made in the installation of the system. Improvement Permit is valid for 60 months from date of issuance.

Signed: Robert B. Galliher

Improvement Permit by: P.C. Moore date 1-17-97

Authorization to Count Existing system inspection by: P.C. Moore date 1-17-97

Authorization to Count Expires 60 mos from issue

Installed by: A-1 Backhoe

Certificate of Completion by: _____ date _____

Operation Permit by Mark Collins date 10-9-97

HEALTH DEPT COPY (WHITE) INSPECTION COPY (FINAL) GREEN OWNER COPY (FINAL) YELLOW INSPECTION COPY (INITIAL) PINK OWNER COPY (INITIAL) GOLD