48595

# IREDELL COUNTY HEALTH DEPARTMENT

STATESVILLE 704-878-5305 MOORESVILLE 704-664-5281

## IMPROVEMENT PERMIT / CERTIFICATE OF COMPLETION / OPERATION PERMIT / EXISTING SYSTEM INSPECTION

PROPERTY DESCRIPTION NO. 16915 DATE 9-1-93 TAX MAP NO. 46-4-A-3

OWNER OR CONTRACTOR Blank Arron PHONE: Business Trautman Home 528-9022

ADDRESS Rt 1 Box 514

LOCATION I-77 S to Amity Hill Rd TR Pilch Rd TR Pear Tree 1/2 mi on L

SUBDIVISION BLOCK / SECTION LOT LOT AREA 6.99 acres SITE CLASS. P5. L.T.A.R. .33

Water Supply: ☑ Individual ☐ Community ☐ Public

Septic Tank: 1000 Gallons; STB 794 Date 3-29-94

Pump Tank: Gallons; PT Date

Nitrification Field: No Fields 1 Square Feet 1080 Linear Feet 360

No Lines 3 Trench Width 36 Trench Depth 18 to 36 Gravel Depth 12

☑ New System ☐ Repair System Type: I, II, III, IV, V, VI

System Description: Conv. Gravity

Repair System Description: Conv. Gravity

Maintenance Agreement Required: ☐ Yes ☑ No

☑ House/Mod. Home ☐ Mobile Home ☐ Business ☐ Other

No. Bedrooms 3 No. Bathrooms 2 No. Employees

Garbage Disposal: ☐ Yes ☑ No

Auto. Dishwasher: ☑ Yes ☐ No


Auto. Washing Machine: ☐ Yes ☐ No

Other

☐ Slab ☑ Crawl Space ☐ Basement w/plumbing ☐ Basement wo/plumbing

Comments

### INITIAL SITE SKETCH

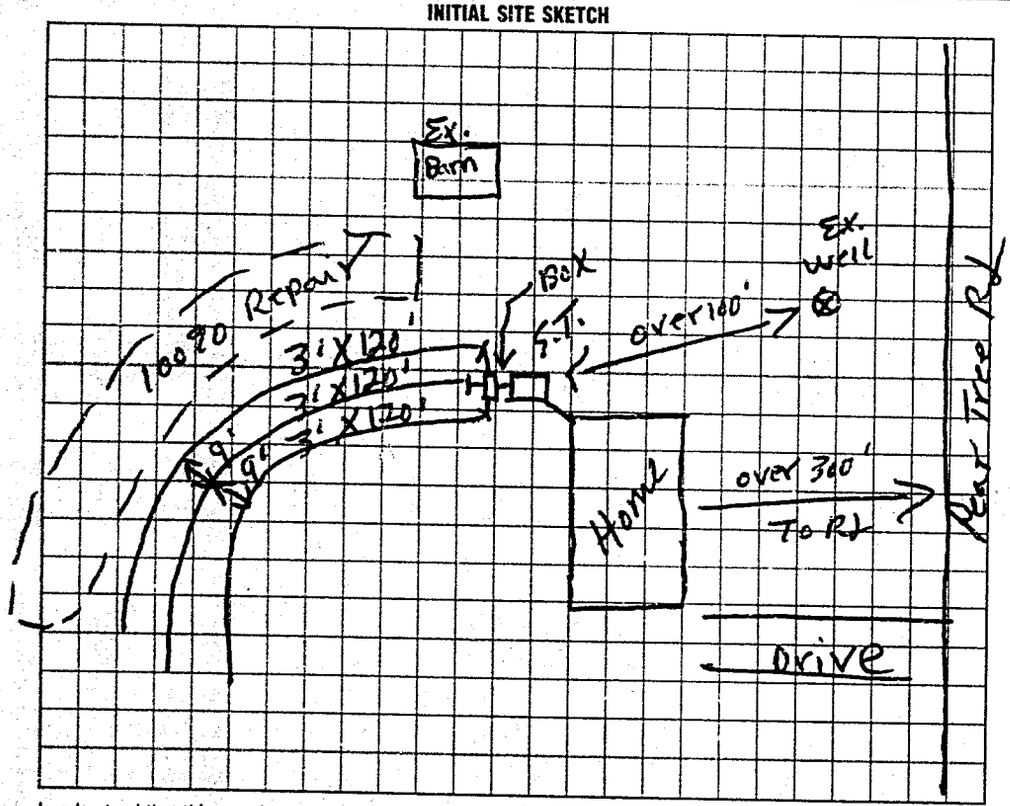


### AS BUILT SKETCH

Same as initial Sketch

I understand that this permit can be suspended or revoked if any false information is supplied toward securing the permit/any unauthorized changes are made to the site/any unauthorized changes are made in the installation of the system. Improvement Permit is valid for 60 months from date of issuance.

Signed: X Nigel Aam

Improvement Permit by: F.C. Moore date 9-1-93

Existing System Inspection by: date

Installed by: J.R. Bowles

Certificate of Completion by: F.C. Moore date 4-29-94

Operation Permit by: date

HEALTH DEPT COPY WHITE INSPECTION COPY (FINAL) GREEN OWNER COPY (FINAL) YELLOW INSPECTION COPY (INITIAL) PINK OWNER COPY (INITIAL) GOLD