IREDELL COUNTY HEALTH DEPARTMENT

Statesville Phone TR 3-7271 — Mooresville Phone NO 3-1271

PERMIT TO INSTALL SEPTIC TANK

Permit NO. _____ Permit Date SEPT 12 1958

Owner LARRY CATES Address IRONMAN, R.F.D.

Installed By HOLLIFIELD Address _____


Location of Property DOWN 21 LEFT AT AMERICAN THREAD CO. GO TILL HIT DIRT ROAD - TAKE LEFT - CROSS 2 CREEKS - ON LEFT

Tank		Capacity		Length of Lines		Fixtures	BRICK
Block	(X)	800	(X)	150'	(X)	No. of Baths	(1)
Precast	( )	900	( )	175'	( )	Dishwasher	( )
		1000	( )	200'	( )	Garbage Grdr.	( )
		1100	( )	225'	( )	Auto-Washer	( )
		1200	( )	250'	( )	Other _____	
		Other _____		Other _____			

NOTIFY HEALTH DEPARTMENT AT LEAST EIGHT HOURS BEFORE TANK IS TO BE INSPECTED.

Final Inspection SEPT 12 1958 Approved (✓) Disapproved ( )

Remarks _____

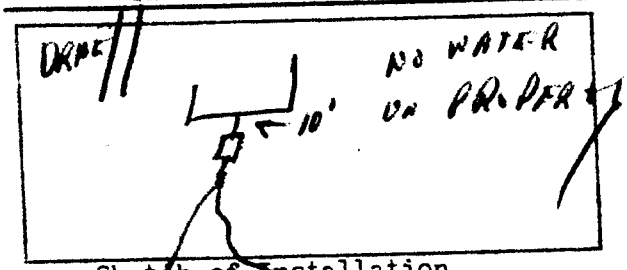

Sketch of Installation

Rufford A. Thomas

Sanitarian