IREDELL COUNTY HEALTH DEPARTMENT

STATESVILLE 704-878-5305 (C) (C) MOORESVILLE 704-664-5281

IMPROVEMENT PERMIT / AUTHORIZATION TO CONSTRUCT / OPERATION PERMIT / EXISTING SYSTEM INSPECTION

PERMIT# 118681 PIN# 4751-06-8842 DATE 2-24-04

OWNER OR CONTRACTOR BRANDON PARKER PHONE: Business 704-201-6627 Home 704-528-1856

ADDRESS 535 SOUTH EASTWAY DR, TROUTMAN, NC 28166

LOCATION US 21 S TL AMITY HILL RD, TR PILCH RD, CONTINUE PEAR TREE, TR FIELDHAVEN PL 1ST ON LEFT

SUBDIVISION KELLY FARMSTEADS BLOCK / SECTION ____ LOT 41 LOT AREA 0.68 ACRE SITE CLASS. PS DESIGN FLOW 360 L.T.A.R. 0.30 GPD/FT²

Septic Tank: 1000 Gallons; STB 760 Date 6-15-04

Pump Tank: ____ Gallons; PT ____ Date ____

Pump Make: ____ Model ____ Serial No. 438

Nitrification Field: No Fields 1 Square Feet 1200 Linear Feet 400

No Lines FOUR Trench Width 36" Max Trench Bottom Depth 36" Gravel Depth 12" (11")

☑ New System ☐ Repair System Type: I, (II), III, IV, V, VI

System Description: CONVENTIONAL, GRAVITY

Repair System Description: 50% REDUCTION, LOW PRESSURE

Maintenance Agreement Required: ☐ Yes ☑ No ☐ Other ____

☑ House/Mod. Home No. Bedrooms 3

☐ Mobile Home No. Bathrooms 2

☐ Business No. Employees ____


☐ Slab ☑ Crawl Space ☐ Basement w/plumbing ☐ Basement wo/plumbing

Water Supply: ☑ Individual ☐ Public ☐ Community WELL


Comments:/Conditions:

Comments:/Conditions: SEPTIC TANK WITH RED "POLY LOK" FILTER INSTALLED, SYSTEM EXPANDED AS SHOWN DUE TO INSUFFICIENT STONE DEPTH (11")

INITIAL SITE SKETCH

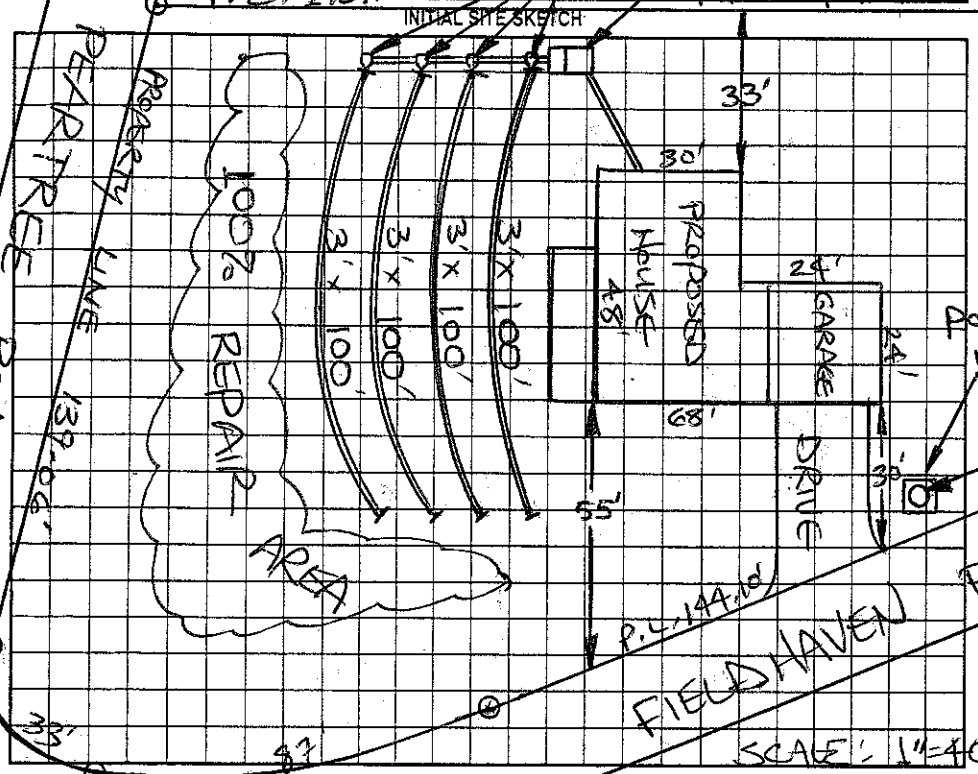

AS BUILT SKETCH

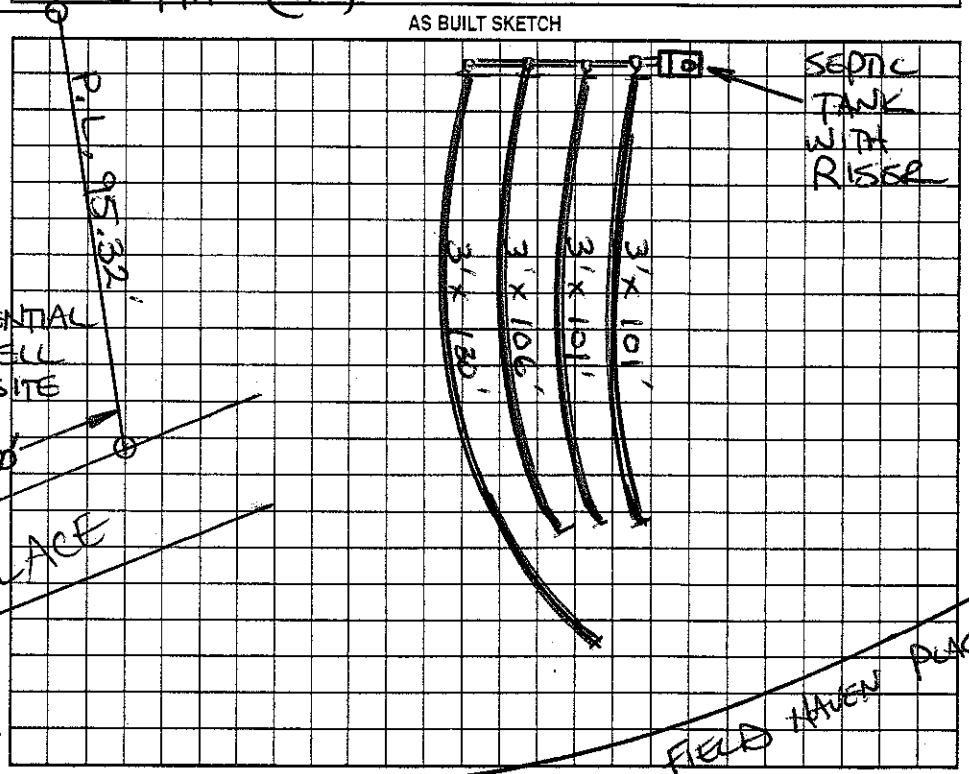

Permit can be suspended or revoked if any false information is supplied toward securing the permit/any unauthorized changes are made to the site/any unauthorized changes are made in the installation of the system. Improvement Permit with plat valid without expiration. Improvement Permit with site plan valid for sixty months. Authorization to Construct is valid for a period equal to that of Improvement Permit – not to exceed sixty months.

Signed: Brandon Lee Parker date 2-24-04 Installed by: MYERS SEPTIC (ROWAN)

Improvement Permit by: STEVE HEDRICK date 2-24-04 Operation Permit by: STEVE HEDRICK date 11-18-04

Authorization to Construct by: STEVE HEDRICK date 2-24-04 Existing System Inspection by: ____ date ____

HEALTH DEPT. COPY: WHITE OWNER COPY (FINAL): YELLOW OWNER COPY (INITIAL): PINK