IREDELL COUNTY HEALTH DEPARTMENT

STATESVILLE 704-878-5305 MOORESVILLE 704-664-5281

IMPROVEMENT PERMIT / AUTHORIZATION TO CONSTRUCT / OPERATION PERMIT / EXISTING SYSTEM INSPECTION

PERMIT# 113180 PIN# 4751-07-7136 DATE 6-24-03

OWNER OR CONTRACTOR KELLY CONSTRUCTION INC PHONE: Business 704-902-4860 Home 704-528-4901

ADDRESS 167 PERTH WOOD DRIVE TROUTMAN NC 28166

LOCATION AMITY HILL ROAD, TR PILCH ROAD, CONTINUE PEAR TREE TR FIELD HAVEN, 3RD LOT ON LEFT

SUBDIVISION KELLY FARMSTEADS BLOCK / SECTION 3 LOT 44 LOT AREA 0.657 ACRE SITE CLASS. PS DESIGN FLOW 360 L.T.A.R. 0.25 GPD/FT2

Septic Tank: 1000 Gallons; STB 312 Date 9-2-03
Pump Tank: ____ Gallons; PT ____ Date ____
Pump Make: ____ Model ____ Serial No. ____
Nitrification Field: No Fields 1 Square Feet 60 x 1440 Linear Feet 360
No Lines SIX Trench Width 36" Max Trench Bottom Depth 36" Gravel Depth N/A

☑ New System ☐ Repair System Type: I, II, III, IV, V, VI
System Description: 25% REDUCTION GRAVITY
Repair System Description: 50% REDUCTION, PUMP
Maintenance Agreement Required: ☐ Yes ☑ No


☑ House/Mod. Home No. Bedrooms 3
☐ Mobile Home No. Bathrooms 2
☐ Business No. Employees ____
☐ Other ____
☐ Slab ☑ Crawl Space ☐ Basement w/plumbing ☐ Basement wo/plumbing

Water Supply:
☑ Individual
☐ Public
☐ Community
WELL

Comments:/Conditions: ① INSTALL 25% REDUCTION SYSTEM ② KEEP SYSTEM MAXIMUM FEASIBLE DISTANCE FROM WELL ③ USE ONE FLOW DIVIDER TEE TO ACHIEVE EQUAL DISTRIBUTION INTO TWO DISTRIBUTION BOXES AS SHOWN.


Comments:/Conditions: ① SEPTIC TANK WITH MARKER & RISERS INSTALLED USING "ZABEL" FILTER ② UPPER FOUR LINES INSPECTED 11-21-03, RSH ③ Lower Two Lines Other okay 11/24-03 WJ

INITIAL SITE SKETCH

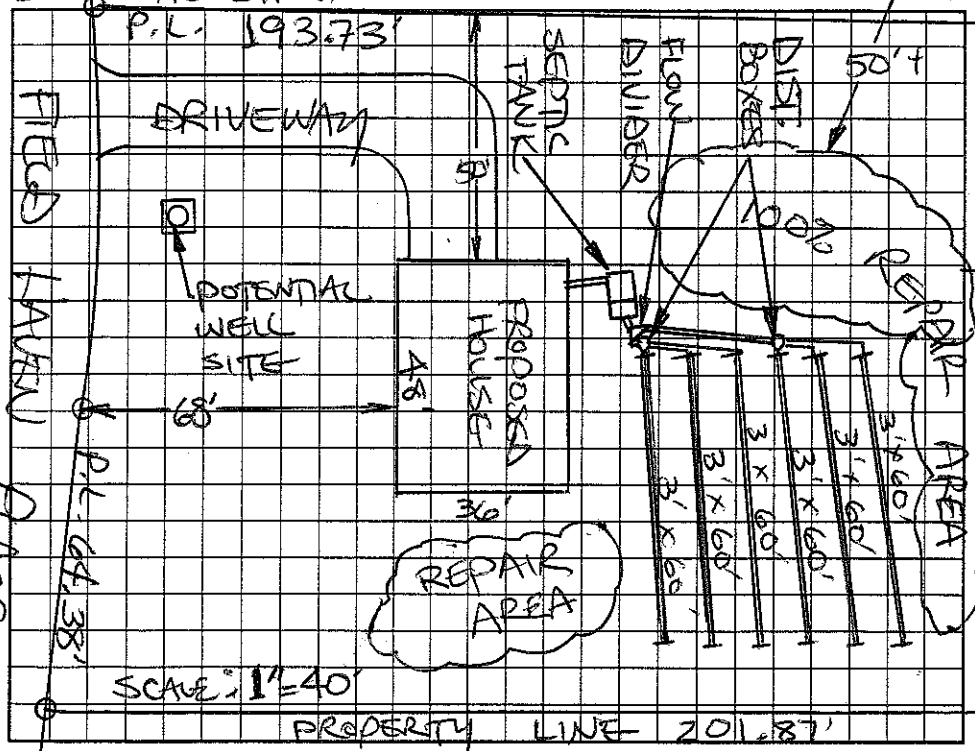

NEIGHBORING WELL

AS BUILT SKETCH

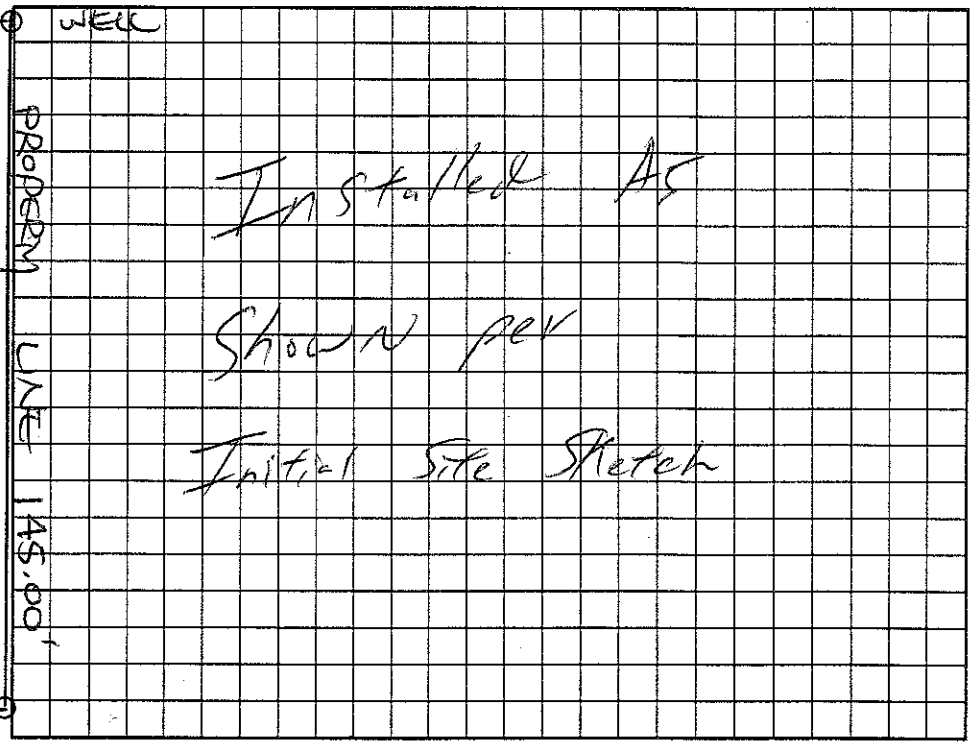

Permit can be suspended or revoked if any false information is supplied toward securing the permit/any unauthorized changes are made to the site/any unauthorized changes are made in the installation of the system. Improvement Permit with plat valid without expiration. Improvement Permit with site plan valid for sixty months. Authorization to Construct is valid for a period equal to that of Improvement Permit – not to exceed sixty months.

Signed: [signature] date 6-24-03 Installed by: Wes Lytton

Improvement Permit by: STEVE HEDRICK date 6-24-03 Operation Permit by: William O Johnson date 11/24/03

Authorization to Construct by: STEVE HEDRICK date 6-24-03 Existing System Inspection by: ____ date ____

HEALTH DEPT. COPY: WHITE OWNER COPY (FINAL): YELLOW OWNER COPY (INITIAL): PINK