IREDELL COUNTY HEALTH DEPARTMENT

Statesville Office (704) 878-5305 Mooresville Office (704) 660-3625 PERMIT # 208985

IMPROVEMENT PERMIT / AUTHORIZATION TO CONSTRUCT / OPERATION PERMIT / EXISTING SYSTEM

PIN # 4751077854

APPLICANT: Judith Walton APPLICANT ADDRESS: 160 Fieldhaven PL Troutman NC 28166

SITE ADDRESS: 160 Field haven PL Troutman NC 28166 PHONE: 704-677-2292 ALT. PHONE: 704-799-8840

SITE DIRECTIONS: Hwy 21 S T/L Oswalt Amity T/L Pilch T/R Field haven


SUBDIVISION: Kelly Farmstead SECTION: P3-52 LOT # 53-54 LOT AREA: 1.53 ac DESIGN FLOW: Ex L.T.A.R.: Ex

Septic Tank	Ex (gal)	STB	Date	☐ New System	☐ Repair	☐ Expansion	System Type: I II III IV V VI	☒ Residence	No. Bedrooms Ex
Pump Tank	(gal)	PT	Date	System Description: Existing				☐ Business	No. Persons Ex
Pump Make		Model	Serial #	Repair System Description:				☐ Other	No. Employees
# Nitrification Fields	Ex # Lines	Ex	Linear Ft: Ex	Maintenance Agreement Required:	☐ YES	☒ NO		☐ Slab	☑ Crawl Space
Trench Width	Ex Max. Trench Bottom Depth	Ex	Gravel Depth N/A		☒ GRAVITY	☐ PRESSURE		☐ Basement w/plumbing	☐ Basement w/o plumbing


Water Supply: ☒ Private ☐ Public ☐ Community

Comments / Conditions: All building foundations must be 25' from any well and 35' from any part of STS.

INITIAL SITE SKETCH

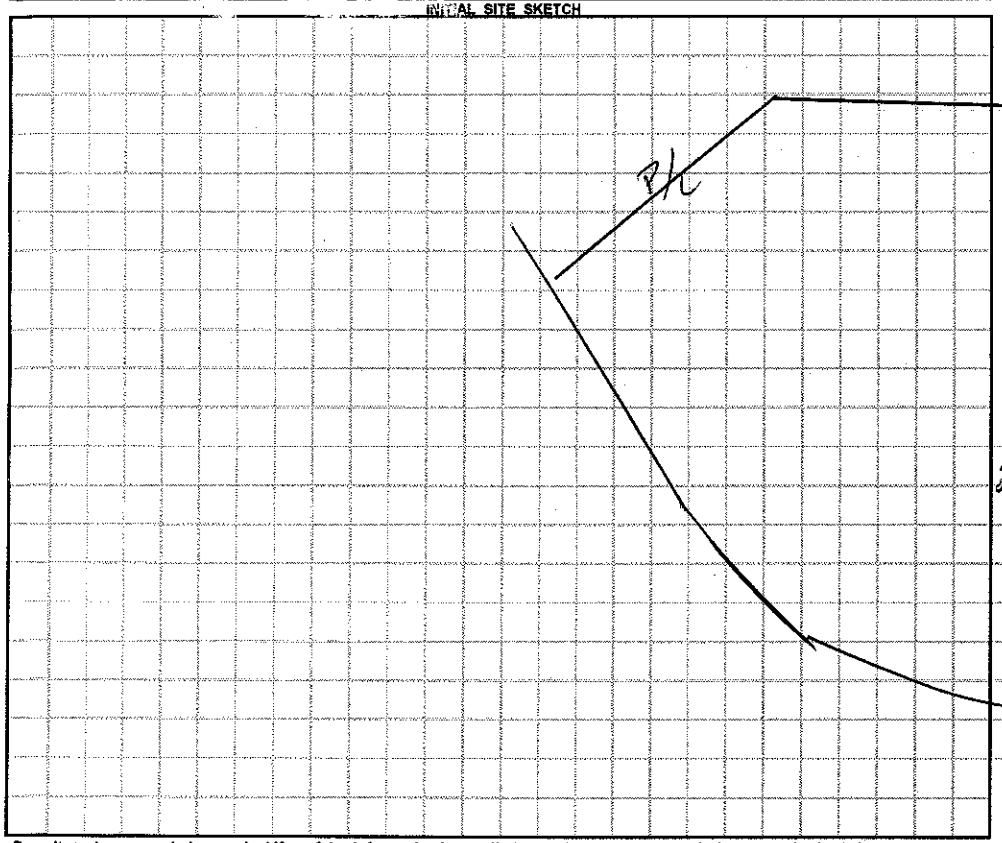

AS BUILT SKETCH

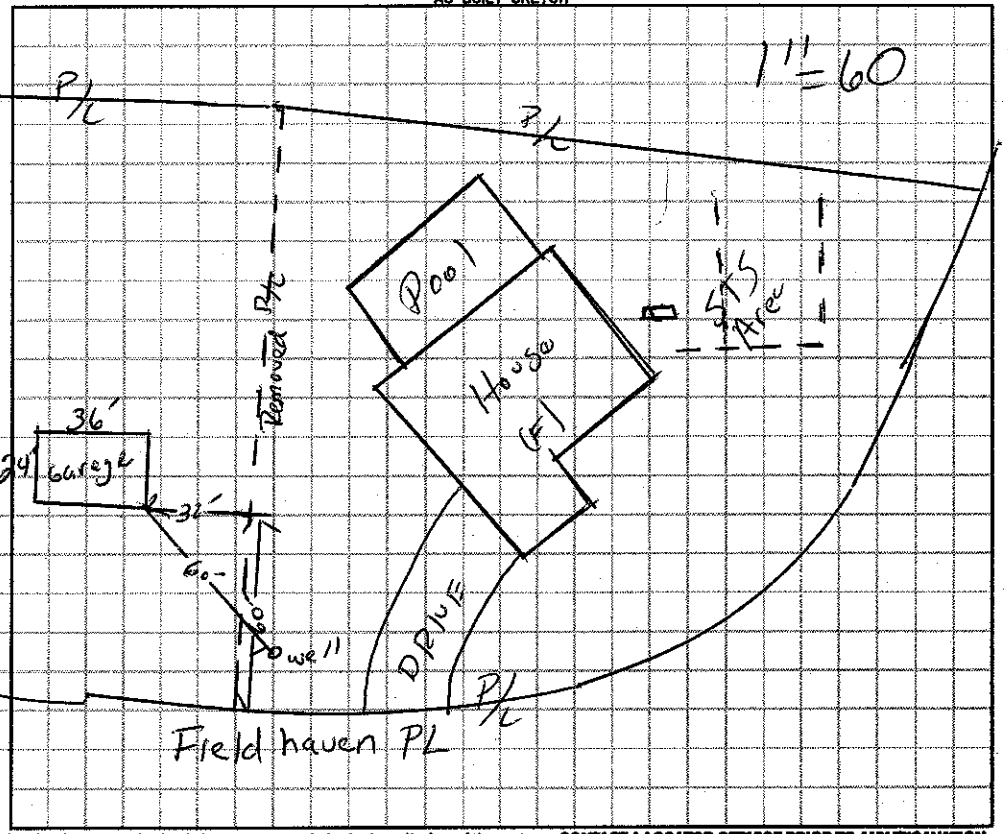

Permit can be suspended or revoked if any false information is supplied toward securing the permit / any unauthorized changes are made to the site / any unauthorized changes are made in the installation of the system. **CONTACT A LOCATOR SERVICE PRIOR TO ANY EXCAVATION**

☐ **IMPROVEMENT PERMIT** *with plat valid without expiration.* ☐ **IMPROVEMENT PERMIT** *with site plan valid for 60 mos.* ☐ **AUTHORIZATION TO CONSTRUCT** *valid for period equal to IMPROVEMENT PERMIT--not to exceed 60 mo.*

Owner / Applicant Signature: Judith Walton Date: 3-23-15 Installed by:

IMPROVEMENT PERMIT by: Date: OPERATION PERMIT by: Date:

AUTHORIZATION TO CONSTRUCT by: Date: Existing System Inspected by: Date: 03/20/15

Health Dept. Copy - WHITE Applicant (Final Approval) - YELLOW Applicant (Conditional Approval) - PINK