IREDELL COUNTY HEALTH DEPARTMENT

STATESVILLE 704-878-5305 (C1) MOORESVILLE 704-664-5281

IMPROVEMENT PERMIT / AUTHORIZATION TO CONSTRUCT / OPERATION PERMIT / EXISTING SYSTEM INSPECTION

PERMIT# 110681 PIN# 4751-07-9150 DATE 01/09/03

OWNER OR CONTRACTOR JIM THOMPSON PHONE: Business 704-361-3050 ~~Home~~ PAUL 704-575-9688

ADDRESS 112 CAMFORTH DR. MOORESVILLE, NC 28117

LOCATION I77, (L) AMITY HILL RD, (R) PILCH, TO PEARTREE, (R) FIELDHAVEN PLACE, (R) GRAY BARN, 1st LOT ON LEFT, ON CORNER,

SUBDIVISION KELLY FARMSTEAD BLOCK / SECTION 3 LOT 26 LOT AREA 0.58 ACRES SITE CLASS PS DESIGN FLOW 360 GPD L.T.A.R. 0.30 GPD/FT²

Septic Tank: 1,000 Gallons; STB 312 Date 4-12-04
Pump Tank: _____ Gallons; PT _____ Date _____
Pump Make: _____ Model _____ Serial No. _____
Nitrification Field: No Fields 1 Square Feet EQ to 1200 Linear Feet 300
No Lines 5 Trench Width 36" Max Trench Bottom Depth 36" Gravel Depth N/A

[X] New System [ ] Repair System Type: I, II, (III), IV, V, VI
System Description: 25% REDUCTION, GRAVITY
Repair System Description: 50% REDUCTION, PUMP
Maintenance Agreement Required: [ ] Yes [X] No


[X] House/Mod. Home No. Bedrooms 3
[ ] Mobile Home No. Bathrooms 2
[ ] Business No. Employees _____
[ ] Other _____
[ ] Slab [X] Crawl Space [ ] Basement w/plumbing [ ] Basement wo/plumbing

Water Supply: [X] Individual [ ] Public [ ] Community
WELL


Comments/Conditions: (1) WELL MUST BE 100' PLUS FROM SYSTEM (15A NCAC 18A .1950(e)(9))

Comments/Conditions: (2) SYSTEM ALTERED AS SHOWN WITH PRIOR HEALTH DEPARTMENT APPROVAL
(3) SEPTIC TANK WITH MARKER INSTALLED USING RED "POLYLOK" FILTER #30130

INITIAL SITE SKETCH

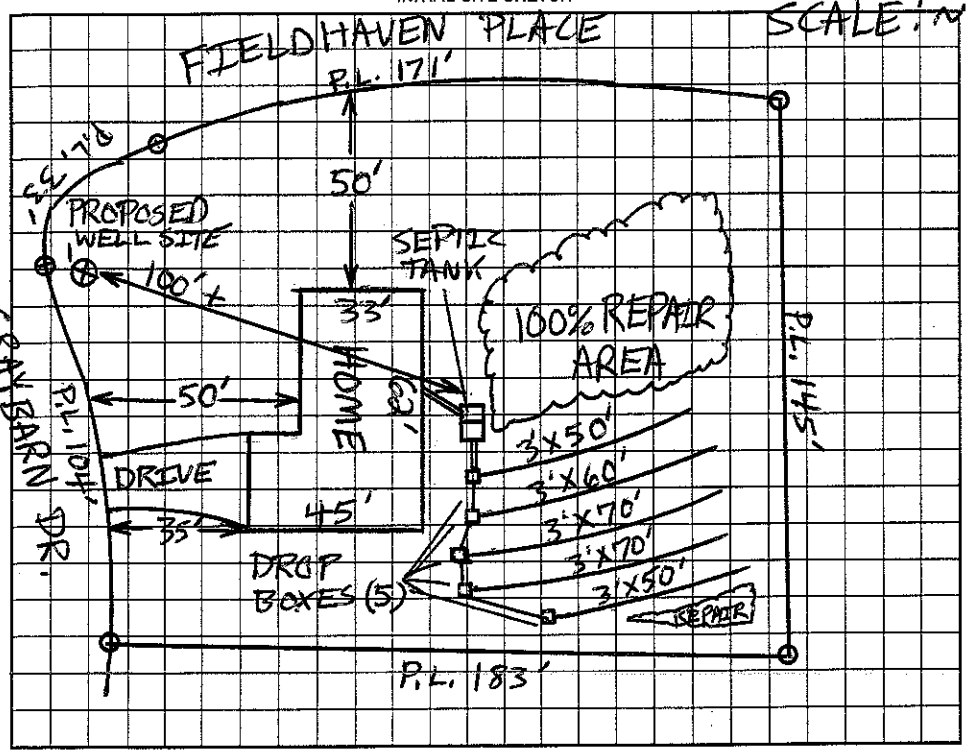

AS BUILT SKETCH

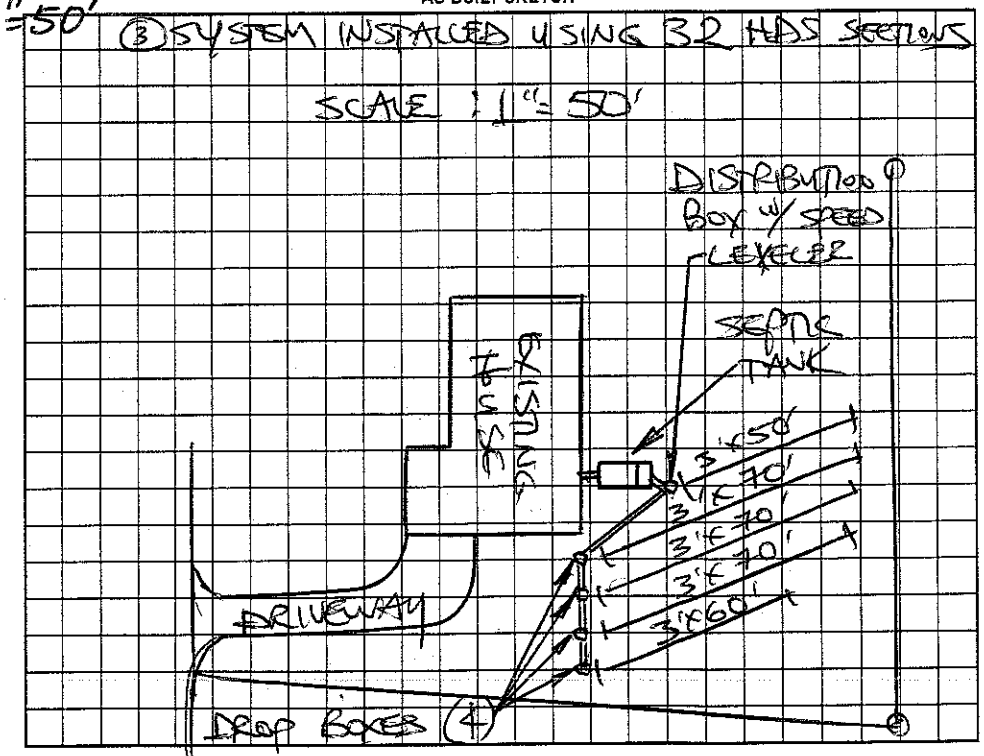

Permit can be suspended or revoked if any false information is supplied toward securing the permit/any unauthorized changes are made to the site/any unauthorized changes are made in the installation of the system. Improvement Permit with plat valid without expiration. Improvement Permit with site plan valid for sixty months. Authorization to Construct is valid for a period equal to that of Improvement Permit – not to exceed sixty months.

Signed: _____ date 9-Jan-03 Installed by: WES LYTTON

Improvement Permit by: Patrick Mitchell date 01/09/03 Operation Permit by: STEVE HENDRICK date 5-19-04

Authorization to Construct by: Patrick Mitchell date 01/09/03 Existing System Inspection by: _____ date _____

HEALTH DEPT. COPY: WHITE OWNER COPY (FINAL): YELLOW OWNER COPY (INITIAL): PINK