IREDELL COUNTY HEALTH DEPARTMENT

ESVILLE 704-878-5305 MOORESVILLE 704-664-5281

3:30-4:00

IMPROVEMENT PERMIT / AUTHORIZATION TO CONSTRUCT / OPERATION PERMIT / EXISTING SYSTEM INSPECTION

PERMIT# 083771 PIN# 4751200659 4751109705

OWNER OR CONTRACTOR Phillip Ostwalt DATE 12-10-99

ADDRESS 169 Mueller's Creek Apt K Statesville, NC 28677 PHONE: Business 634-5570 Cell. Home (704) 878-0253

LOCATION Amity Hill TR Pilch TR Ostwalt Amity TR Franklin Woods or Hwy 115 N. TR Oswalt/Amity TR Franklin Woods 871-9731 Misty

SUBDIVISION BLOCK / SECTION LOT LOT AREA Acreage SITE CLASS. PS DESIGN FLOW 360 L.T.A.R. .35+-.4

Septic Tank: 1000 Gallons; STB 1012 Date 10-16-99

Pump Tank: Gallons; PT Date

Pump Make: Model Serial No.

Nitrification Field: No Fields 1 Square Feet 1080' Linear Feet 360'

No Lines 6 at 60' or 3 at 120' Trench Width 36" Max Trench Bottom Depth 36"+ Gravel Depth 12"

☒ New System ☐ Repair System Type: I, II, III, IV, V, VI

System Description: Gravity - Conventional

Repair System Description: Pumped - Modified

Maintenance Agreement Required: ☐ Yes ☒ No

☒ House/Mod. Home ☐ Mobile Home ☐ Business ☐ Other

No. Bedrooms 3 No. Bathrooms 2 No. Employees


Water Supply: ☒ Individual ☐ Public ☐ Community

☐ Slab ☒ Crawl Space ☒ Basement w/plumbing ☐ Basement wo/plumbing


Comments:/Conditions: Keep Septic System 10' from PL, 100' from well & 5' from House (downgradient of basement). Keep drainlines 15' from road cut. Filter-a-Filter = Installed

Comments:/Conditions: Note: Either Install 3-lines at 120' ea or 6 lines at 60' ea. Install Septic tank downgradient of future house. Drop Boxes installed in middle of lines. Need Speed Levelers in D-Box

INITIAL SITE SKETCH Not to Scale

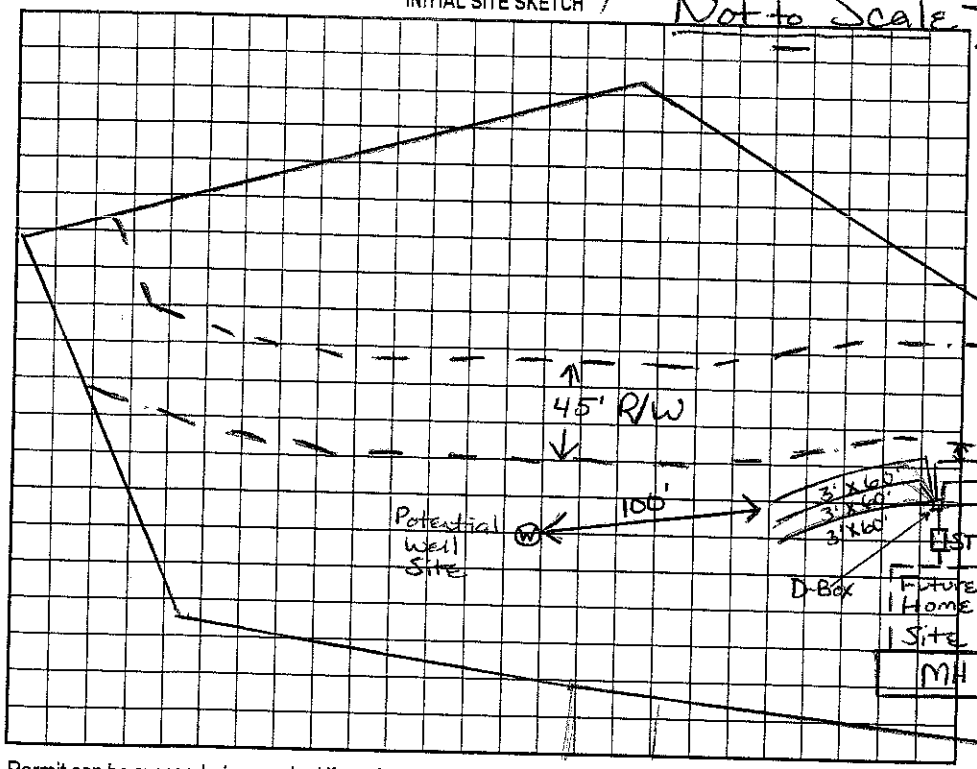

AS BUILT SKETCH

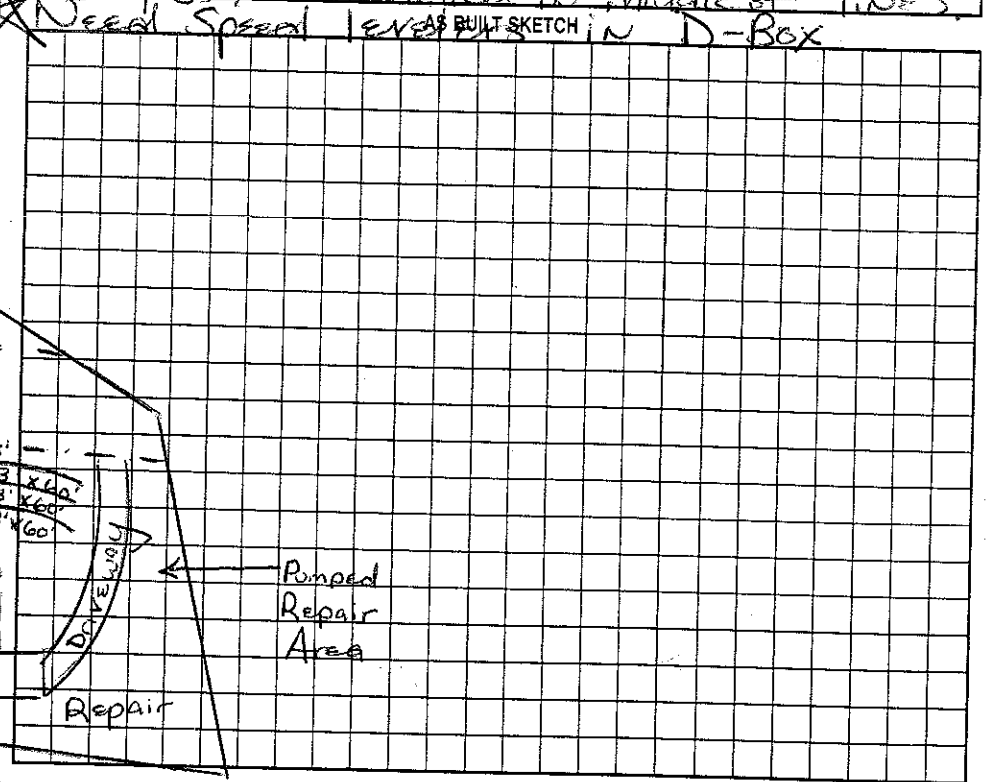

Permit can be suspended or revoked if any false information is supplied toward securing the permit/any unauthorized changes are made to the site/any unauthorized changes are made in the installation of the system. Improvement Permit with plat valid without expiration. Improvement Permit with site plan valid for sixty months. Authorization to Construct is valid for a period equal to that of Improvement Permit – not to exceed sixty months.

Signed: Phillip R. Ostwalt date 12/13/99

Improvement Permit by: Maria H. Dotson RS. date 12/10/99

Authorization to Construct by: Maria H. Dotson RS. date 12/10/99

Installed by: Craig Thompson Grading

Operation Permit by: Maria H. Dotson RS date 2/15/2000

Existing System Inspection by: date

HEALTH DEPT. COPY: WHITE OWNER COPY (FINAL): YELLOW OWNER COPY (INITIAL): PINK