IREDELL COUNTY HEALTH DEPARTMENT

STATESVILLE 704-878-5305 MOORESVILLE 704-664-5281

IMPROVEMENT PERMIT / CERTIFICATE OF COMPLETION / OPERATION PERMIT / EXISTING SYSTEM INSPECTION

PROPERTY DESCRIPTION NO. 65893 DATE 5-6-97

OWNER OR CONTRACTOR Robert Gallihey TAX MAP NO. 4751027310 Watershed: ☐ Yes ☑ No

ADDRESS 357 Oswalt Amity Rd PHONE: Business Home 7045284906

LOCATION US 21 S To Oswalt Amity X I-77 1/2 mi left

SUBDIVISION Stillmeadows BLOCK / SECTION LOT 18 LOT AREA 28283 SITE CLASS. PS DESIGN FLOW 360 L.T.A.R. .13

Septic Tank: 1000 Gallons; STB 1012 Date 8-30-97

Pump Tank: Gallons; PT Date

Pump Make: Model Serial No.

Nitrification Field: No Fields 1 Square Feet 400 Linear Feet 200

No Lines 2 Trench Width 24" Max Trench Bottom Depth 36" Gravel Depth N/A

☑ New System ☐ Repair System Type: I, II, III, IV, V, VI

System Description: Gravity Panel

Repair System Description:

Maintenance Agreement Required: ☐ Yes ☐ No

☐ House/Mod. Home No. Bedrooms 3

☐ Mobile Home No. Bathrooms 2

☐ Business No. Employees

☐ Other


☐ Slab ☐ Crawl Space ☐ Basement w/plumbing ☐ Basement wo/plumbing

Water Supply: ☑ Individual ☐ Community ☐ Public


Comments:

Comments:
~~A~~ Note lines are splitfeed
SDF - SDFt
Home shifted

INITIAL SITE SKETCH

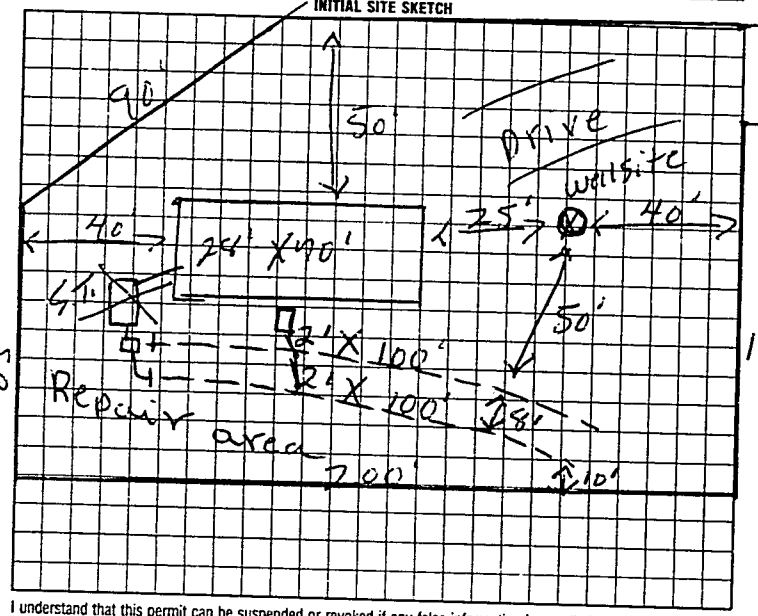

AS-BUILT SKETCH

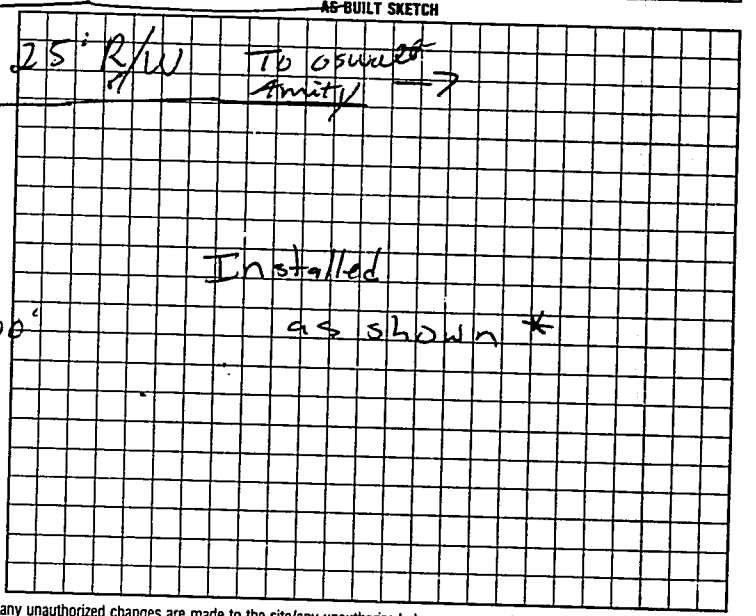

I understand that this permit can be suspended or revoked if any false information is supplied toward securing the permit/any unauthorized changes are made to the site/any unauthorized changes are made in the installation of the system. Improvement Permit is valid for 60 months from date of issuance.

Signed: Robert B Gallihey 5-8-97

Improvement Permit by: L. C. Moore date 5-6-97

Existing System Inspection by: L. C. Moore date 5-6-97

Authorization to Count

HEALTH DEPT. COPY: WHITE INSPECTION COPY (FINAL): GREEN OWNER COPY (FINAL): YELLOW

Installed by: A-1 Backhoe

Certificate of Completion by: date

Operation Permit by: Mark C. Ott RS date 11-19-97

INSPECTION COPY (INITIAL): PINK OWNER COPY (INITIAL): GOLD

Authorization to Count Expires 60 mos from issue

279000