IREDELL COUNTY HEALTH DEPARTMENT

AUTHORIZATION TO CONSTRUCT 4751122171

STATESVILLE 704-878-5305 MOORESVILLE 704-664-5281

IMPROVEMENT PERMIT / ~~CERTIFICATE OF COMPLETION~~ / OPERATION PERMIT / EXISTING SYSTEM INSPECTION

PROPERTY DESCRIPTION NO. 067991 DATE 7/30/97 TAX MAP NO. 4751114583 pt

OWNER OR CONTRACTOR DON SPARKS PHONE: Business — Home — Watershed: ☐ Yes ☑ No

ADDRESS C/O 405 OSTWALT AMITY RD - TROUTMAN NC 28166

LOCATION OSWALT AMITY. CROSS I77 - OR RT BEFORE 405 OSTWALT AMITY

SUBDIVISION — BLOCK / SECTION — LOT — LOT AREA 1.463 AC SITE CLASS. BS DESIGN FLOW 360 L.T.A.R. .3

Septic Tank: 1000 Gallons; STB 1012 Date 8/12/97

Pump Tank: — Gallons; PT — Date —

Pump Make: — Model — Serial No. —

Nitrification Field: No Fields 1 Square Feet 1200 Linear Feet 400

No Lines 3 @ 133' Trench Width 36" Max Trench Bottom Depth 36" Gravel Depth 12"

☑ New System ☐ Repair System Type: I, (II), III, IV, V, VI

System Description: GRAVITY CONVENTIONAL

Repair System Description: CHAMBERED

Maintenance Agreement Required: ☐ Yes ☑ No

☑ House/Mod. Home ☐ Mobile Home ☐ Business ☐ Other

No. Bedrooms 3 No. Bathrooms 2 No. Employees —


☐ Slab ☑ Crawl Space ☐ Basement w/plumbing ☐ Basement wo/plumbing

Water Supply: ☑ Individual ☐ Community ☐ Public


Comments:

Comments: TANK LOCATION TO OTHER SIDE OF HOUSE

INITIAL SITE SKETCH 1" = 50'

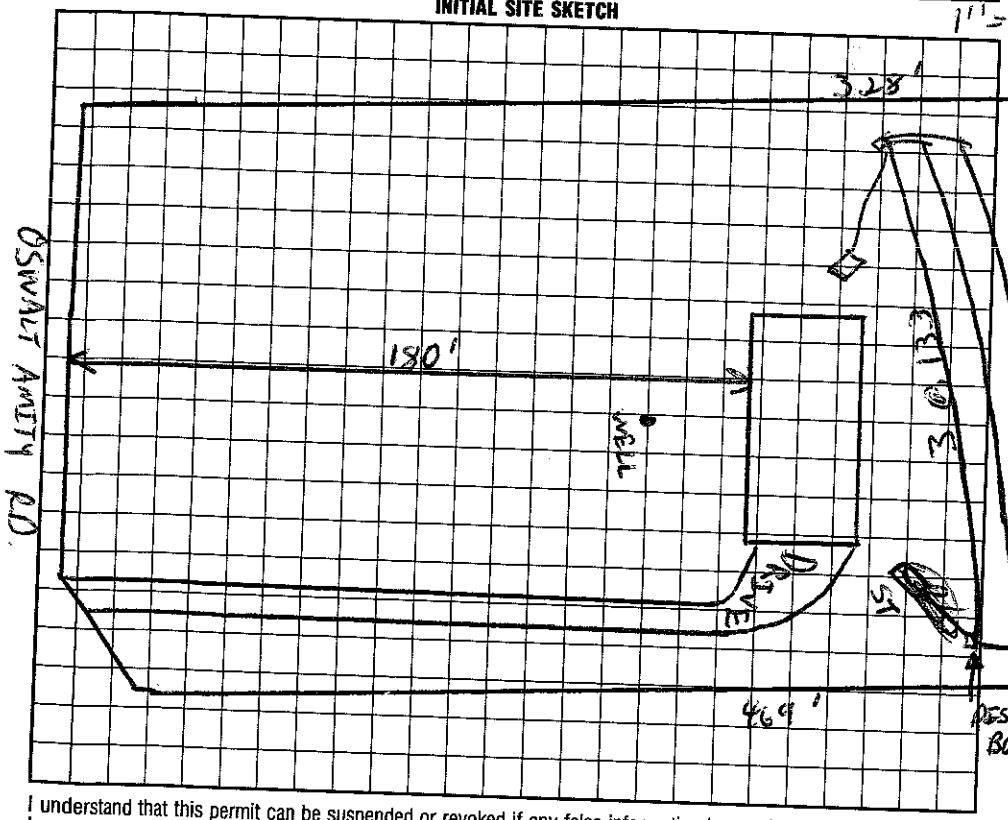

AS BUILT SKETCH

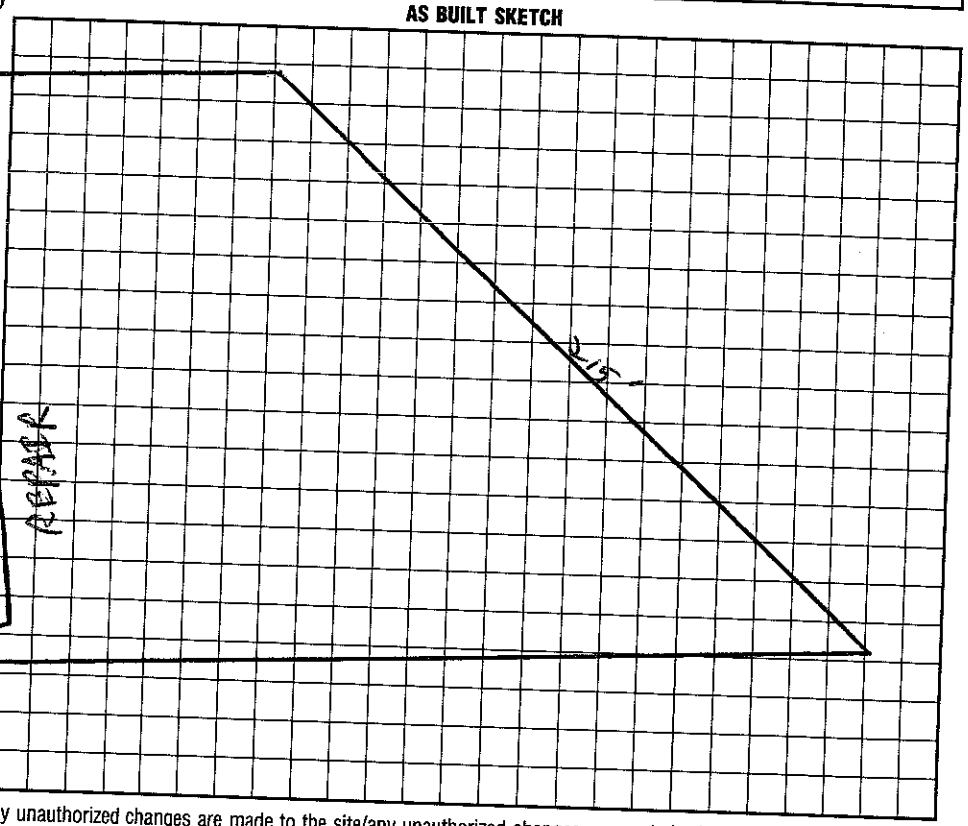

I understand that this permit can be suspended or revoked if any false information is supplied toward securing the permit/any unauthorized changes are made to the site/any unauthorized changes are made in the installation of the system. Improvement Permit is valid for 60 months from date of issuance.

Signed: [signature]

Improvement Permit by: [signature] date 7/30/97

~~Existing System Inspection by:~~ AUTHORIZATION TO CONSTRUCT [signature] date 7/30/97

Installed by: STEVE JORDAN

Certificate of Completion by: — date —

Operation Permit by: [signature] date 11/3/97

HEALTH DEPT. COPY: WHITE INSPECTION COPY (FINAL): GREEN OWNER COPY (FINAL): YELLOW INSPECTION COPY (INITIAL): PINK OWNER COPY (INITIAL): GOLD