IREDELL COUNTY HEALTH DEPARTMENT

STATESVILLE 704-878-5305 MOORESVILLE 704-664-5281

IMPROVEMENT PERMIT / CERTIFICATE OF COMPLETION / OPERATION PERMIT / EXISTING SYSTEM INSPECTION

PROPERTY DESCRIPTION NO. 25837 DATE 1-17-97 TAX MAP NO. 4751-02-7310 Watershed: ☐ Yes ☑ No

OWNER OR CONTRACTOR Robert Galliher PHONE: Business _____ Home 528-4906

ADDRESS 357 Oswalt Amity Rd Troutman, N.C.

LOCATION 215 To Oswalt Amity Past Stillmeadows Rd 3rd lot left.

SUBDIVISION Stillmeadows BLOCK / SECTION _____ LOT 17 LOT AREA 20522 SITE CLASS. RS DESIGN FLOW 360 L.T.A.R. 13

Septic Tank: 1000 Gallons; STB 1012 Date 11-2-96

Pump Tank: _____ Gallons; PT _____ Date _____

Pump Make: _____ Model _____ Serial No _____

Nitrification Field: No Fields 1 Square Feet 1200 Linear Feet 400

No Lines 4 Trench Width 36" Max Trench Bottom Depth 36" Gravel Depth 12"

☑ New System ☐ Repair System Type: I. II. III. IV. V. VI

System Description: Conv. Gravity

Repair System Description: Gravity Chambers

Maintenance Agreement Required: ☐ Yes ☑ No

☐ House/Mod. Home No. Bedrooms 3

☑ Mobile Home No. Bathrooms 2

☐ Business No. Employees ____

☐ Other _____


☐ Slab ☑ Crawl Space ☐ Basement w/plumbing ☐ Basement wo/plumbing

Water Supply: ☑ Individual ☐ Community ☐ Public


Comments:

Comments:

INITIAL SITE SKETCH

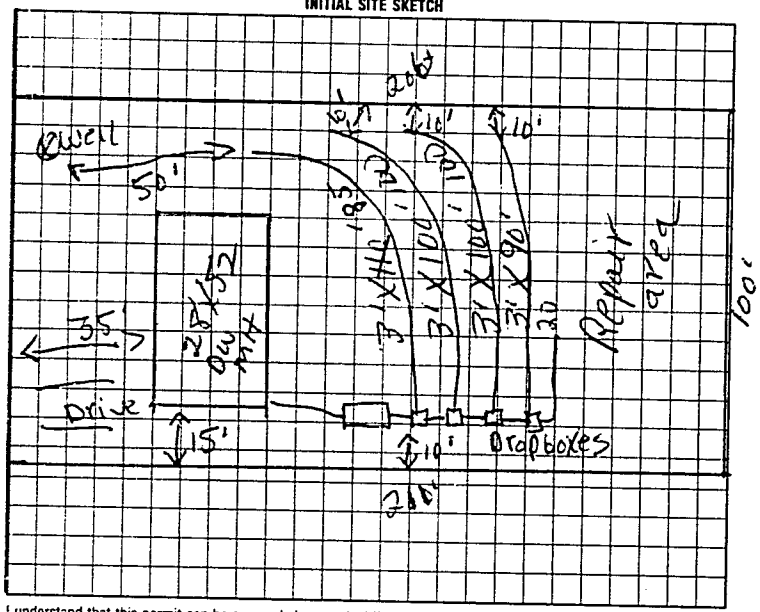

AS BUILT SKETCH

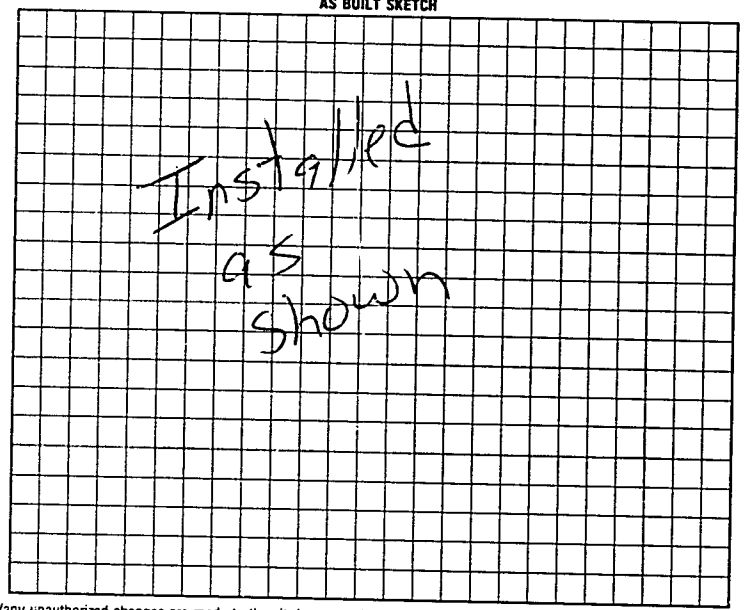

I understand that this permit can be suspended or revoked if any false information is supplied toward securing the permit/any unauthorized changes are made to the site/any unauthorized changes are made in the installation of the system. Improvement Permit is valid for 60 months from date of issuance.

Signed: Robert B. Galliher

Improvement Permit by: P.C. Moore date 1-17-97

Authorization to Court Existing System Inspection by: P.C. Moore date 1-17-97

Installed by: A-1 Backhoe

Certificate of Completion by: _____ date _____

Operation Permit by: Mary C. Ott date 2-18-97

HEALTH DEPT. COPY: WHITE INSPECTION COPY (FINAL): GREEN OWNER COPY (FINAL): YELLOW INSPECTION COPY (INITIAL): PINK OWNER COPY (INITIAL): GOLD

to Court: Authorization to Court Expires 60 mos From 1-17-97