IREDELL COUNTY HEALTH DEPARTMENT

STATESVILLE 704-878-5305 MOORESVILLE 704-664-5281

IMPROVEMENT PERMIT / AUTHORIZATION TO CONSTRUCT / OPERATION PERMIT / EXISTING SYSTEM INSPECTION

PERMIT# 82955 PIN# 4751147077 DATE 7-29-99

OWNER OR CONTRACTOR Kenneth Hoffman PHONE: Business _____ Home _____

ADDRESS 645 Normandy Rd Mooresville, N.C.

LOCATION Oswalt Amity Turn Pitch Turn 1st Left Skylight 500' RT

SUBDIVISION Helen Sherrill BLOCK / SECTION _____ LOT 1 LOT AREA 1.69 acres SITE CLASS PS DESIGN FLOW 360 L.T.A.R. .33

Septic Tank: 1000 Gallons; STB 825 Date 4-21-99

Pump Tank: _____ Gallons; PT _____ Date _____

Pump Make: _____ Model 1200 Serial No. 400

Nitrification Field: No Fields 1 Square Feet ~~1080~~ Linear Feet ~~360~~

No Lines ~~4~~ 3 Trench Width 36" Max Trench Bottom Depth 36" Gravel Depth 12"

☑ New System ☐ Repair System Type: ☐ I ☐ II ☐ III ☐ IV ☐ V ☐ VI

System Description: Conv. Gravity

Repair System Description: " "

Maintenance Agreement Required: ☐ Yes ☑ No

☐ House/Mod. Home No. Bedrooms 3

☑ Mobile Home No. Bathrooms 2

☐ Business No. Employees ____

☐ Other _____


☐ Slab ☑ Crawl Space ☐ Basement w/plumbing ☐ Basement wo/plumbing

Water Supply: ☑ Individual ☐ Public ☐ Community

Comments/Conditions:


Comments/Conditions: See Attached

INITIAL SITE SKETCH

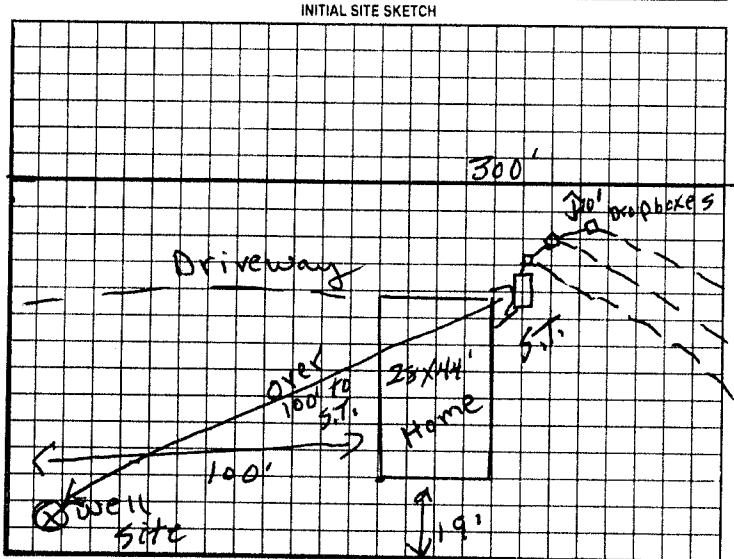

AS BUILT SKETCH

Sheet for as built sketch

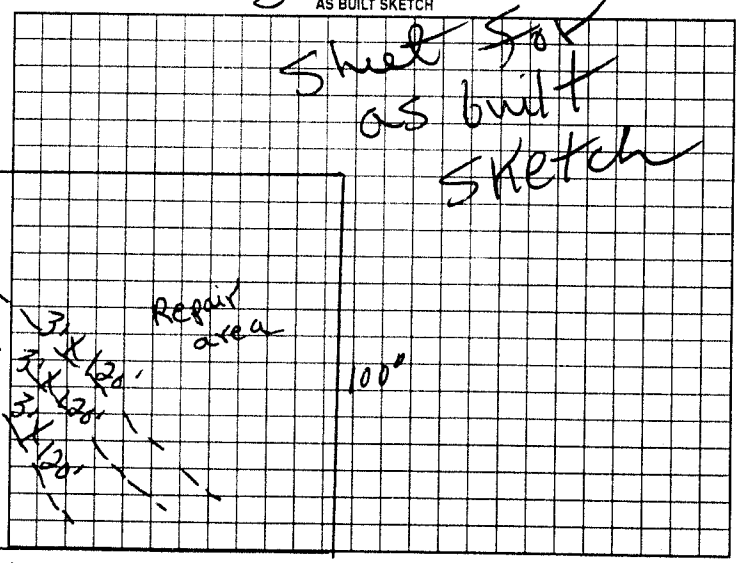

Permit can be suspended or revoked if any false information is supplied toward securing the permit/any unauthorized changes are made to the site/any unauthorized changes are made in the installation of the system. Improvement Permit with plat valid without expiration. Improvement Permit with site plan valid for sixty months. Authorization to Construct is valid for a period equal to that of Improvement Permit – not to exceed sixty months.

Signed: X Kenneth M Hoffman date 7-29-99 Installed by: _____

Improvement Permit by: R.C. Moore date 7-29-99 Operation Permit by: _____ date _____

Authorization to Construct by: R.C. Moore date 7-29-99 Existing System Inspection by: _____ date _____

HEALTH DEPT COPY: WHITE OWNER COPY (FINAL) YELLOW OWNER COPY (INITIAL) PINK