IREDELL COUNTY HEALTH DEPARTMENT

STATESVILLE 704-878-5305 (1) MOORESVILLE 704-664-5281

IMPROVEMENT PERMIT / AUTHORIZATION TO CONSTRUCT / OPERATION PERMIT / EXISTING SYSTEM INSPECTION

PERMIT# 116972 PIN# 4751-14-9103 DATE 12-10-03

OWNER OR CONTRACTOR MILLARD RYDELL COWAN PHONE: Business Home 704-528-4083

ADDRESS 847 PERRY ROAD, TROUTMAN, NC 28166

LOCATION US 21 SOUTH, TL OSWALT AMITY ROAD, TL PILCH ROAD, LOT ON LEFT BEHIND BOX #430

SUBDIVISION BLOCK / SECTION LOT 1 LOT AREA 0.587 ACRE SITE CLASS. PS DESIGN FLOW 240 L.T.A.R. 0.20 GPD/FT²

Septic Tank: 1000 Gallons; STB 1012 Date 6-23-03

Pump Tank: Gallons; PT Date

Pump Make: Model Serial No.

Nitrification Field: No Fields 1 Square Feet EST 1200 Linear Feet 300

No Lines FOUR Trench Width 36" Max Trench Bottom Depth 36"

☑ New System ☐ Repair System Type: I, II, (III), IV, V, VI

System Description: 25% REDUCTION, GRAVITY

Repair System Description: 25% REDUCTION, GRAVITY

Maintenance Agreement Required: ☐ Yes ☑ No

Gravel Depth N/A

☐ House/Mod. Home ☑ Mobile Home ☐ Business ☐ Other

No. Bedrooms 2 No. Bathrooms 2 No. Employees

☐ Slab ☑ Crawl Space ☐ Basement w/plumbing ☐ Basement wo/plumbing


Water Supply: ☑ Individual ☐ Public ☐ Community NEIGHBORING WELL

Comments:/Conditions: (1) INSTALL SEPTIC TANK AT GRADE TO ENSURE TRENCH DEPTH OF 36" OR LESS (2) INSTALL 25% REDUCTION SYSTEM AS FLAGGED (3) NO VEHICULAR TRAFFIC ALLOWED OVER SYSTEM

Comments:/Conditions: SYSTEM SIZED FOR 2 BEDROOMS ONLY

SEPTIC TANK WITH MARKER INSTALLED USING "TUFFTE" FILTER

INITIAL SITE SKETCH SCALE: 1" = 40'

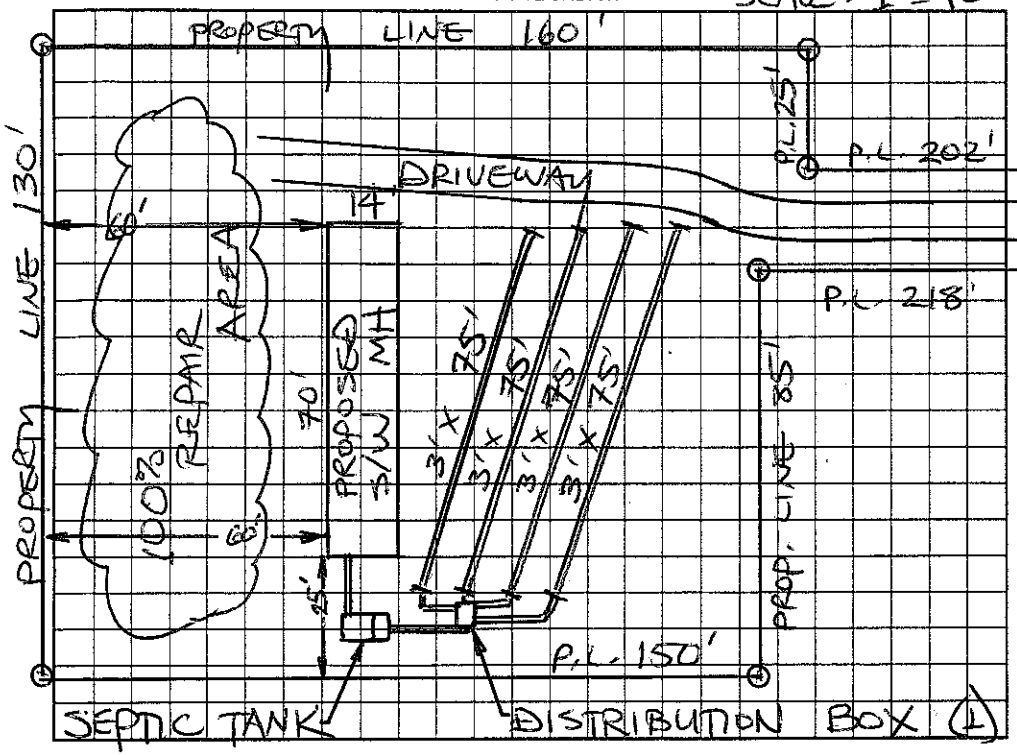

AS BUILT SKETCH

SYSTEM INSTALLED ACCORDING TO INITAL SITE SKETCH

Permit can be suspended or revoked if any false information is supplied toward securing the permit/any unauthorized changes are made to the site/any unauthorized changes are made in the installation of the system. Improvement Permit with plat valid without expiration. Improvement Permit with site plan valid for sixty months. Authorization to Construct is valid for a period equal to that of Improvement Permit – not to exceed sixty months.

Signed: [signature] date 12-12-03 Installed by: A-1 BACKHOE

Improvement Permit by: STEVE HEDRICK date 12-10-03 Operation Permit by: STEVE HEDRICK date 12-18-03

Authorization to Construct by: STEVE HEDRICK date 12-10-03 Existing System Inspection by: date

HEALTH DEPT. COPY: WHITE OWNER COPY (FINAL): YELLOW OWNER COPY (INITIAL): PINK