47791

IREDELL COUNTY HEALTH DEPARTMENT

STATESVILLE 704-878-5305 MOORESVILLE 704-664-5281

IMPROVEMENT PERMIT / CERTIFICATE OF COMPLETION / OPERATION PERMIT / EXISTING SYSTEM INSPECTION

PROPERTY DESCRIPTION NO. 16554 DATE 6-24-93 TAX MAP NO. 46-4-A-1

OWNER OR CONTRACTOR Jessy Kelly PHONE: Business Same Home 528-4701

ADDRESS At 1 Box 68N Troutman

LOCATION I-77 S TH Amity Hill Rd TR Pilch TR Pear Tree 300' on left

SUBDIVISION Kelly Property BLOCK / SECTION LOT 1 LOT AREA 3/4 acre SITE CLASS. PS. L.T.A.R. 4

Water Supply: ☐ Individual ☐ Community ☐ Public

Septic Tank: 1250 Gallons; STB 564 Date 6-22-93

Pump Tank: Gallons; PT Date

Nitrification Field: No Fields 1 Square Feet 1200 Linear Feet 400

No Lines 4 Trench Width 36 Trench Depth 24 Gravel Depth 12"

☐ New System ☐ Repair System Type: I. II. IV. V. VI

System Description: Conv. Gravity

Repair System Description: Porus Block Panel / Gravity

Maintenance Agreement Required: ☑ Yes ☐ No

☑ House/Mod. Home No. Bedrooms 4 Garbage Disposal: ☐ Yes ☑ No

☐ Mobile Home No. Bathrooms 2½ Auto. Dishwasher: ☑ Yes ☐ No


☐ Business No. Employees Auto. Washing Machine: ☑ Yes ☐ No

☐ Other Other


☐ Slab ☑ Crawl Space ☐ Basement w/plumbing ☐ Basement wo/plumbing

Comments Pipe cutters away from S.T. System

INITIAL SITE SKETCH

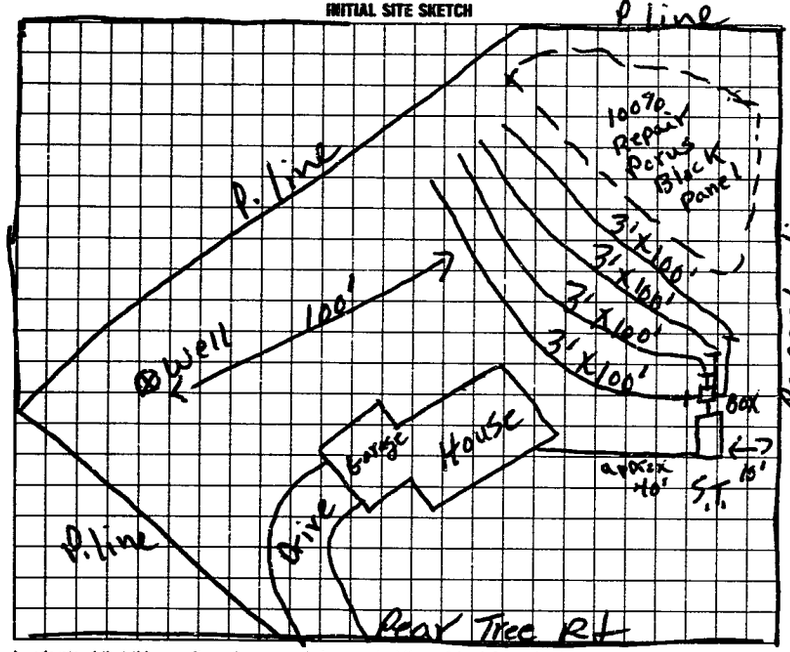

AS BUILT SKETCH

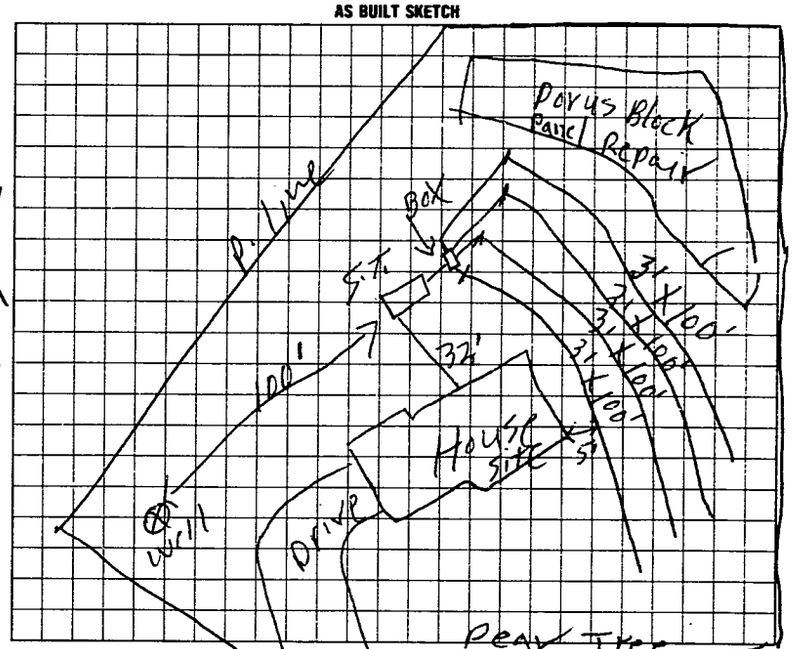

I understand that this permit can be suspended or revoked if any false information is supplied toward securing the permit/any unauthorized changes are made ~~to the site/any unauthorized changes are made~~ in the installation of the system. Improvement Permit is valid for 60 months from date of issuance.

Signed: x Jessy Kelly

Improvement Permit by: E.C. Moore date 6-24-93

Existing System Inspection by: date

Installed by: Wes Eytton

Certificate of Completion by: E. C. Moore date 10-29-93

Operation Permit by: date

HEALTH DEPT. COPY: WHITE INSPECTION COPY (FINAL): GREEN OWNER COPY (FINAL): YELLOW INSPECTION COPY (INITIAL): PINK OWNER COPY (INITIAL): GOLD