IREDELL COUNTY HEALTH DEPARTMENT

STATESVILLE 704-878-5305 MOORESVILLE 704-664-5281

IMPROVEMENT PERMIT / CERTIFICATE OF COMPLETION / OPERATION PERMIT / EXISTING SYSTEM INSPECTION

PROPERTY DESCRIPTION NO. 16653 DATE 8-4-93 TAX MAP NO. 46-B-50

OWNER OR CONTRACTOR Ashley Fiyler PHONE: Business Home 528 6592

ADDRESS Rt 1 Box 540 Troutman N.C.

LOCATION I-77 S to Amity Hill TR Pitch Rd at corner Pear Tree Rd

SUBDIVISION BLOCK / SECTION LOT LOT AREA 100'X200' SITE CLASS. PS L.T.A.R. .4

Water Supply: ☑ Individual ☐ Community ☐ Public

Septic Tank: 1000 Gallons: STB 358 Date 6-30-93

Pump Tank: Gallons: PT Date

Nitrification Field: No Fields 1 Square Feet 900 Linear Feet 300

No Lines 4 Trench Width 36 Trench Depth 15 to 36 Gravel Depth 12

☑ New System ☐ Repair System Type: I, II, III, IV, V, VI

System Description: Conv. Gravity

Repair System Description: " "

Maintenance Agreement Required: ☐ Yes ☑ No

☐ House/Mod. Home No. Bedrooms 3 Garbage Disposal: ☐ Yes ☑ No

☐ Mobile Home No. Bathrooms 2 Auto. Dishwasher: ☐ Yes ☐ No


☐ Business No. Employees Auto. Washing Machine: ☐ Yes ☐ No

☐ Other Other


☐ Slab ☐ Crawl Space ☐ Basement w/plumbing ☐ Basement wo/plumbing

Comments S.T. location moved down slope approx 20' Repair area had to be changed accordingly

INITIAL SITE SKETCH

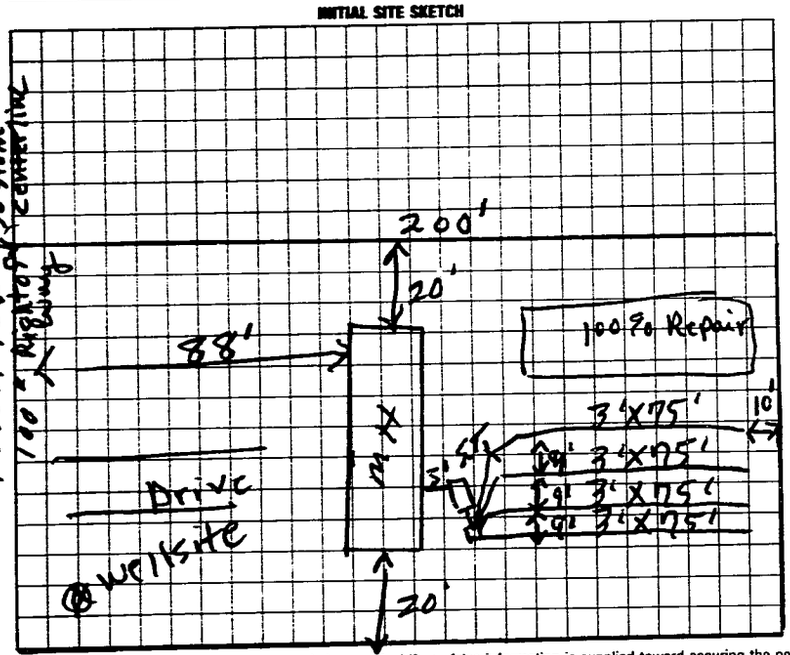

AS BUILT SKETCH

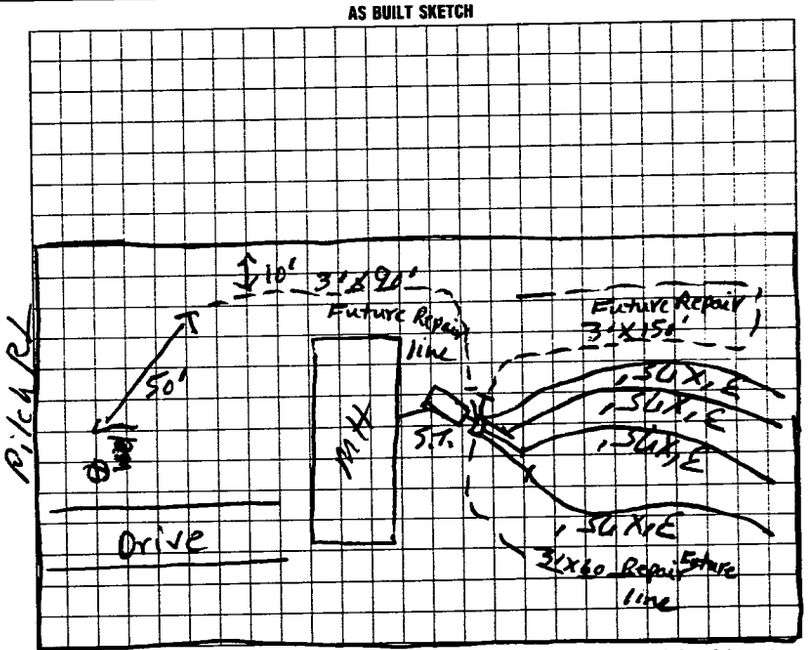

I understand that this permit can be suspended or revoked if any false information is supplied toward securing the permit/any unauthorized changes are made to the site/any unauthorized changes are made in the installation of the system. Improvement Permit is valid for 60 months from date of issuance.

Signed: Walt Pyle

Improvement Permit by: P.C. moore date 8-4-93

Existing System Inspection by: date

Installed by: Wayne Potts

Certificate of Completion by: P.C. moore date 9-13-93

Operation Permit by: date

HEALTH DEPT. COPY: WHITE INSPECTION COPY (FINAL): GREEN OWNER COPY (FINAL): YELLOW INSPECTION COPY (INITIAL): PINK OWNER COPY (INITIAL): GOLD