IREDELL COUNTY HEALTH DEPARTMENT

STATESVILLE 704-878-5305 (c1) MOORESVILLE 704-664-5281

IMPROVEMENT PERMIT / AUTHORIZATION TO CONSTRUCT / OPERATION PERMIT / EXISTING SYSTEM INSPECTION

PERMIT# 413154D PIN# 4751162618 DATE 10-13-05

OWNER OR CONTRACTOR Kimberly Butler PHONE: Business 704 8924400 Home

ADDRESS 149 Jenny Marie Mooresville NC 28115

LOCATION 77 S Left 150 R Amity Hill Road (R) Pilche (R) Pear Tree Lot 40 on right

SUBDIVISION Kelly Farmstead BLOCK / SECTION LOT 40 LOT AREA .687 SITE CLASS PS DESIGN FLOW 360 L.T.A.R. .125


Septic Tank: 1000 Gallons; STB 1007 Date 1-28-06 Pump Tank: Gallons; PT Date Pump Make: Model Serial No. Nitrification Field: No Fields Square Feet 1440 Linear Feet 360 No Lines 5 Trench Width 36 Max Trench Bottom Depth 21"	☑ New System ☐ Repair System Type: I II (III) IV, V, VI System Description: 25% Gravity Repair System Description: LPP 5X130 Trench Maintenance Agreement Required: ☐ Yes ☐ No Repair Gravel Depth	☑ House/Mod. Home No. Bedrooms 3 ☐ Mobile Home No. Bathrooms ☐ Business No. Employees ☐ Other ☐ Slab ☐ Crawl Space ☐ Basement w/plumbing ☐ Basement wo/plumbing

Water Supply: ☑ Individual ☐ Public ☐ Community

Comments:/Conditions: 1) Maintain all setbacks Install on contour - Stub out high on plumbing to insure gravity system

Comments:/Conditions: ① SEPTIC TANK WITH MARKER INSTALLED USING ② BOWCO INDUSTRIES FILTER
Repair Interceptor drain will have to be installed due to lateral water movement

INITIAL SITE SKETCH

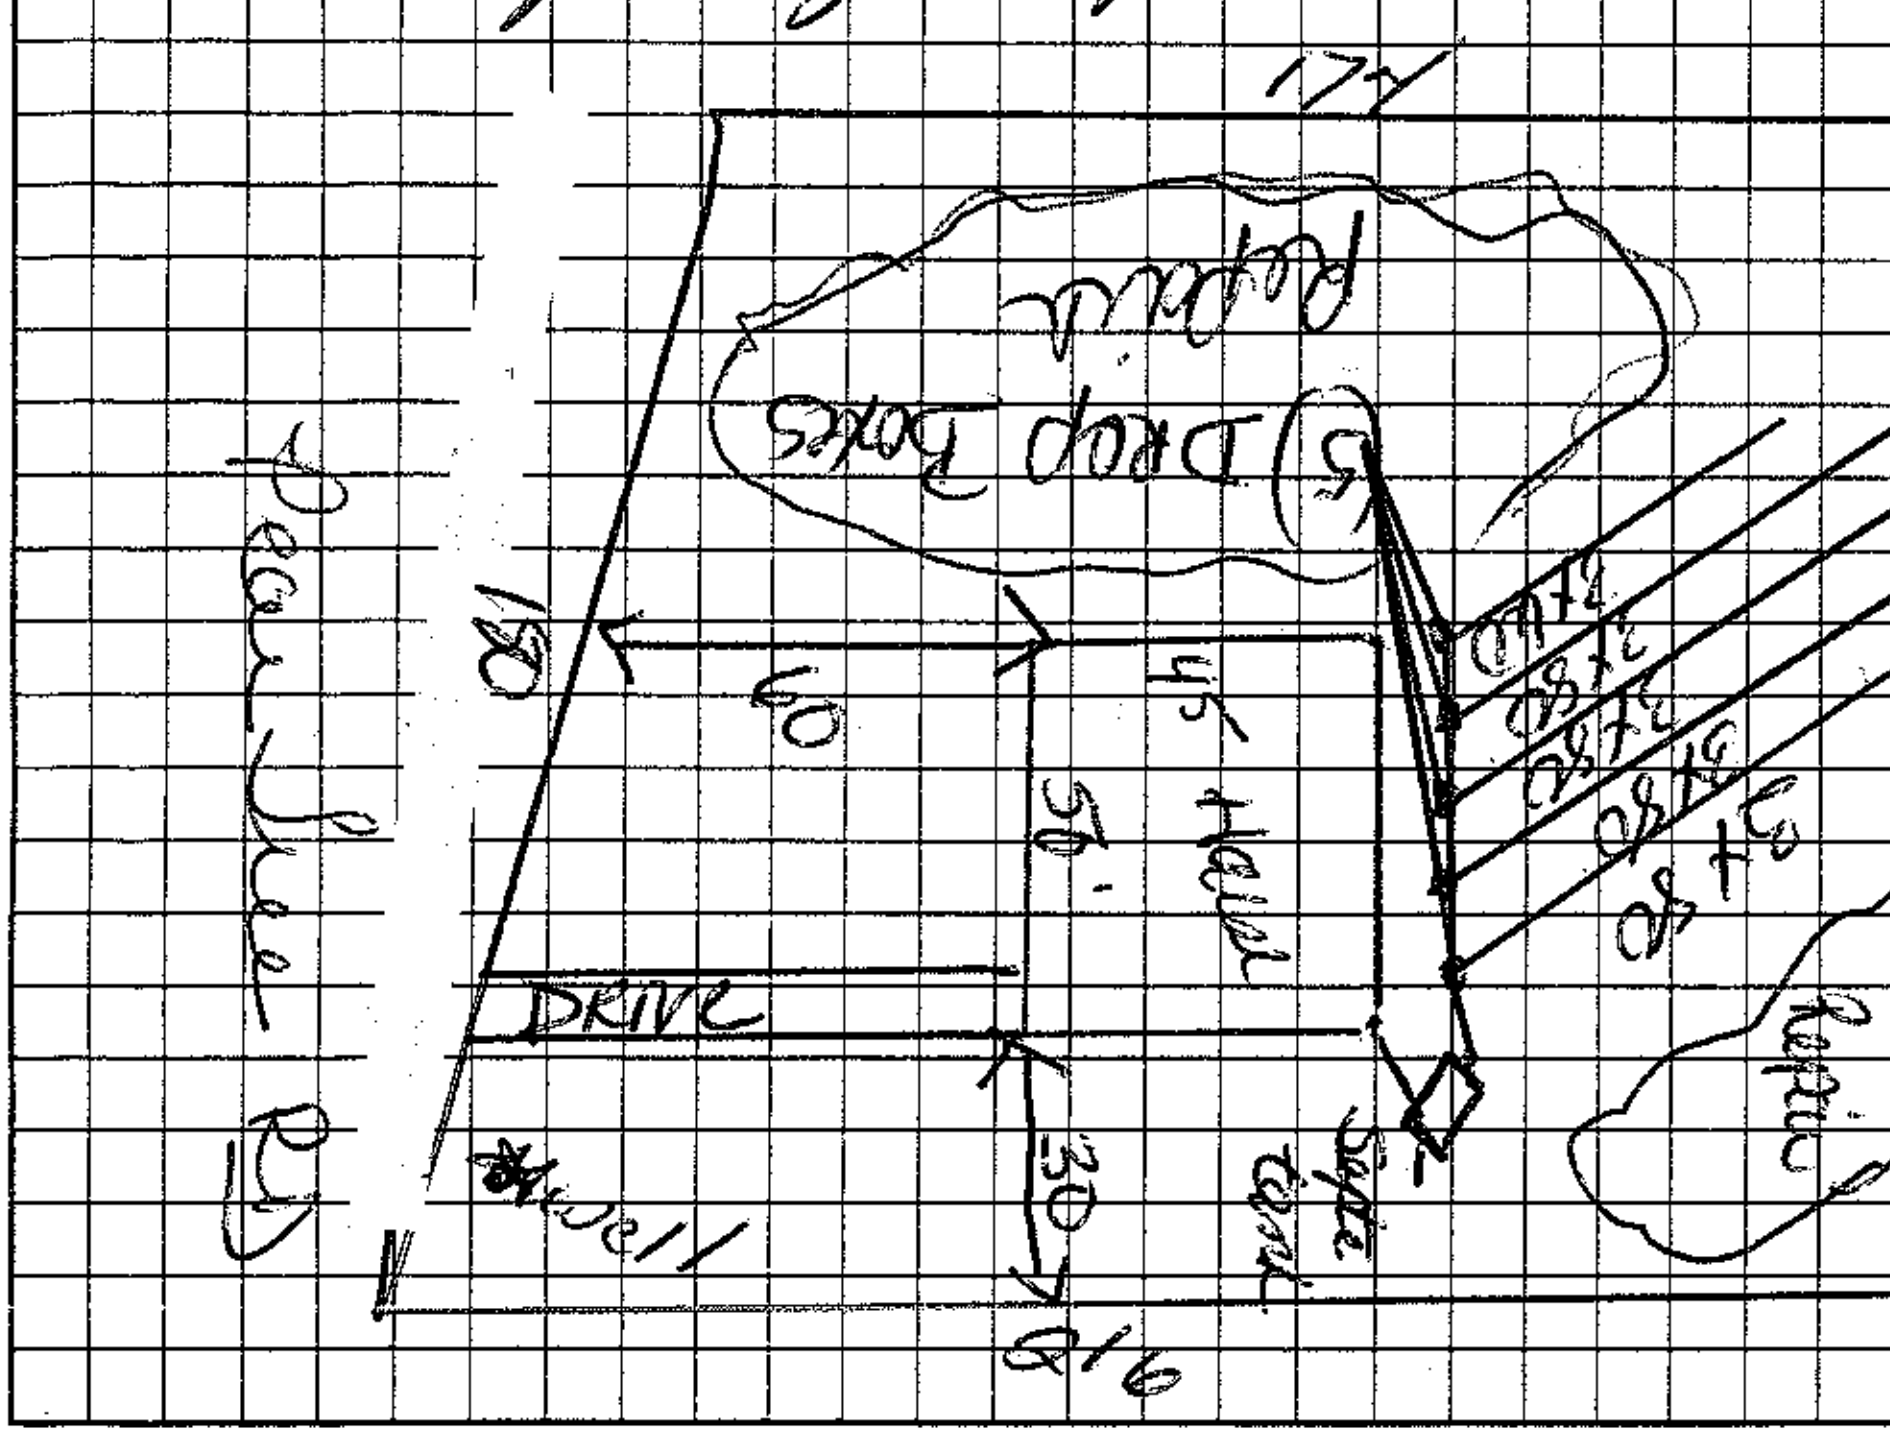

AS BUILT SKETCH

*21' Trench Bottom

157

SYSTEM INSTALLED AS SHOWN USING 90 "INFILTRATOR QUICK-4" CHAMBERS WITH "MULTIPORT" END CAPS USED FOR SERIAL DISTRIBUTION

Permit can be suspended or revoked if any false information is supplied toward securing the permit/any unauthorized changes are made to the site/any unauthorized changes are made in the installation of the system. Improvement Permit with plat valid without expiration. Improvement Permit with site plan valid for sixty months. Authorization to Construct is valid for a period equal to that of Improvement Permit – not to exceed sixty months.

Signed: Kim Butler date Installed by: Wayne Clontz

Improvement Permit by: Kelly Cook date 10-13-05 Operation Permit by: Steve Hedrick date 1-31-07

Authorization to Construct by: Kelly Cook date 10-13-05 Existing System Inspection by: date

HEALTH DEPT. COPY: WHITE OWNER COPY (FINAL): YELLOW OWNER COPY (INITIAL): PINK