IREDELL COUNTY HEALTH DEPARTMENT

STATESVILLE 704-878-5305 MOORESVILLE 704-664-5281

IMPROVEMENT PERMIT / AUTHORIZATION TO CONSTRUCT / OPERATION PERMIT / EXISTING SYSTEM INSPECTION

PERMIT# 87577 PIN# 4751163698 DATE 1-21-00

OWNER OR CONTRACTOR William Lien PHONE: Business _____ Home 528 3955

ADDRESS 162 Pear Tree Rd Troutman, N.C.

LOCATION Amity Hill Road TR Pilch TR Pear Tree 5th House on Rt

SUBDIVISION _____ BLOCK / SECTION _____ LOT _____ LOT AREA 2.0 acres SITE CLASS. PS DESIGN FLOW 360 L.T.A.R. .33

Septic Tank: 1000 Gallons; STB 1012 Date 7-27-99
Pump Tank: _____ Gallons; PT _____ Date _____
Pump Make: _____ Model _____ Serial No. _____
Nitrification Field: No. Fields 1 Square Feet 1080 Linear Feet 360
No. Lines 4 Trench Width 36" Max Trench Bottom Depth 36" Gravel Depth 12"

☐ New System ☐ Repair System Type: I, II, III, IV, V, VI
System Description: _____
Repair System Description: Conv Gravity
Maintenance Agreement Required: ☐ Yes ☒ No

☒ House/Mod. Home No. Bedrooms 3
☐ Mobile Home No. Bathrooms 2
☐ Business No. Employees _____
☐ Other _____
☐ Slab ☒ Crawl Space ☐ Basement w/plumbing ☐ Basement wo/plumbing


Water Supply: ☒ Individual ☐ Public ☐ Community

Comments/Conditions:

Comments/Conditions:
Attic, Attached Garage + Total 1 Bedroom to make it 3BR Hse

INITIAL SITE SKETCH

AS BUILT SKETCH

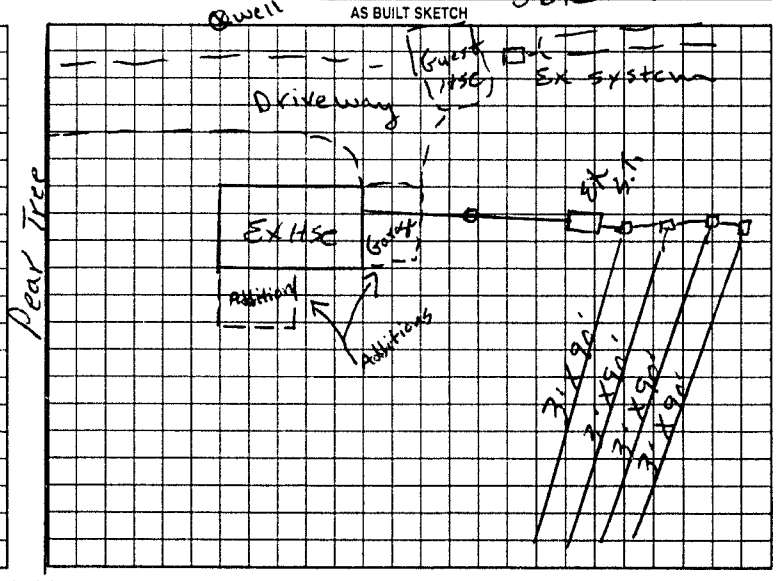

Permit can be suspended or revoked if any false information is supplied toward securing the permit/any unauthorized changes are made to the site/any unauthorized changes are made in the installation of the system. Improvement Permit with plat valid without expiration. Improvement Permit with site plan valid for sixty months. Authorization to Construct is valid for a period equal to that of Improvement Permit – not to exceed sixty months.

Signed: _____ date _____ Installed by: Donald Lackey

Improvement Permit by: _____ date _____ Operation Permit by: R. C. Moore date 10-6-99

Authorization to Construct by: _____ date _____ Existing System Inspection by: R. C. Moore date 1-21-00

HEALTH DEPT. COPY: WHITE OWNER COPY (FINAL): YELLOW OWNER COPY (INITIAL): PINK