IREDELL COUNTY HEALTH DEPARTMENT

STATESVILLE 704-878-5305 MOORESVILLE 704-664-5281

IMPROVEMENT PERMIT / AUTHORIZATION TO CONSTRUCT / OPERATION PERMIT / EXISTING SYSTEM INSPECTION

PERMIT# _____ PIN# _____ DATE 4-13-99

OWNER OR CONTRACTOR William Loden PHONE: Business 872-5063 Home _____

ADDRESS 162 Peay Tree Troutman N.C.

LOCATION I-77 TL Amity Hill TR Rich TR Pear Tree 1/4 mi Rt.

SUBDIVISION _____ BLOCK / SECTION _____ LOT _____ LOT AREA _____ SITE CLASS PS DESIGN FLOW 360 L.T.A.R. .33

Septic Tank: 1000 Gallons; STB 1012 Date 7-21-99
Pump Tank: _____ Gallons; PT _____ Date _____
Pump Make: _____ Model _____ Serial No. _____
Nitrification Field: No Fields 1 Square Feet 1080 Linear Feet 360
No Lines 4 Trench Width 36" Max Trench Bottom Depth 36" Gravel Depth 12"

☐ New System ☑ Repair System Type: I, II, III, IV, V, VI
System Description: _____
Repair System Description: conv. Gravity
Maintenance Agreement Required: ☐ Yes ☐ No
☐ Slab ☑ Crawl Space ☐ Basement w/plumbing ☐ Basement wo/plumbing


☑ House/Mod. Home No. Bedrooms 3
☐ Mobile Home No. Bathrooms 2
☐ Business No. Employees _____
☐ Other _____

Water Supply:
☑ Individual
☐ Public
☐ Community

Comments/Conditions:

Comments/Conditions:

INITIAL SITE SKETCH

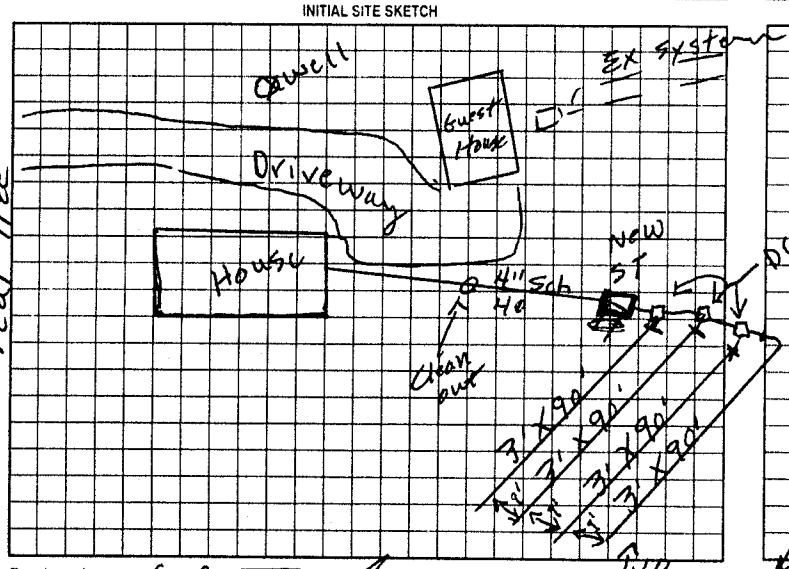

AS BUILT SKETCH

Same as initial Sketch

Permit can be suspended or revoked if any false information is supplied toward securing the permit/any unauthorized changes are made to the site/any unauthorized changes are made in the installation of the system. Improvement Permit with plat valid without expiration. Improvement Permit with site plan valid for sixty months. Authorization to Construct is valid for a period equal to that of Improvement Permit – not to exceed sixty months.

Signed: _____ date _____ Installed by: Donald Lackey

Improvement Permit by: E. C. Moore date 4-13-99 Operation Permit by: E. C. Moore date 10-6-99

Authorization to Construct by: E. C. Moore date 4-13-99 Existing System Inspection by: _____ date _____

HEALTH DEPT COPY WHITE OWNER COPY (FINAL) YELLOW OWNER COPY (INITIAL) PINK